Walthall
K 1053

MISSISSIPPI DEPARTMENT OF NATURAL RESOURCES
Bureau of Land and Water Resources
Southport Mall
P.O. Box 10631
Jackson, Mississippi 39209

WATER WELL DRILLERS LOG

8-8 1983 T. Gerald Weed Sr Walthall
date well completed firm name county well located

LANDOWNER: Ozel Stogner
RR- Tylertown Ms.
(mailing address)

WELL LOCATION:
sec. 18 T 1 N/S R 12 E/W
9 miles SE of Tylertown
(distance) (direction) (nearest town)

WELL PURPOSE: Home
(home, irrigation, municipal, industrial)

WELL COMPLETION DATA:
(1) diameter (inches) 4
(2) total depth (feet) 139
(3) static water level (feet) 68 below ~~above~~ top of ground.
(4) casing PVC (material), 131 (depth), 4 (size) if telescope see back.
(5) screen 8 (length), 131 (depth to top), 4 (size), PVC (material)
(6) pump 1/2 (HP) 10 (yield gpm) Elec (type power)
(7) electric log No (yes or no)
(organization running log)
(8) how well bottom plugged Bal Stk

DRILLERS REMARKS:

description of formations encountered	from	to
Red Clay	0	20
Red Sand	20	125
Coarse Sand & Gravel	125	139

DEPT. OF NATURAL RESOURCES
BUREAU OF LAND & WATER RESOURCES
AUG 15 1983
RECEIVED

If well telescopes please sketch and show depths.

GROUND LEVEL

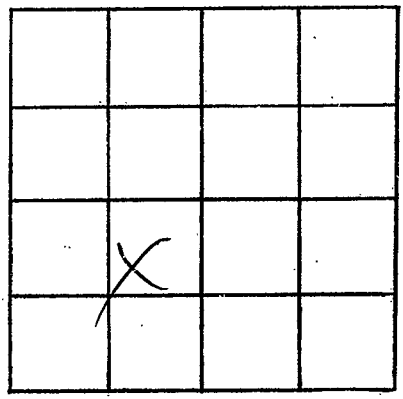

SECTION 18

Please indicate well location X.

ADDITIONAL INFORMATION

*If more than one screen, show locations of each on sketch.