WALTHALL
L25
7-8-74

# MISSISSIPPI
# BOARD OF WATER COMMISSIONERS
416 North State Street
Jackson, Mississippi 39201

CODED

## WATER WELL DRILLERS LOG

7-8 1974 Briner-Cinn Walthall
date well completed — firm name — county well located

LANDOWNER: Arnold Hilton
Rt. 7 Tylertown, Miss.
(mailing address)

WELL LOCATION:
sec. 5 T 1 N ~~S~~ R 13 E ~~W~~
12 miles SE of Tylertown
(distance) (direction) (nearest town)

WELL PURPOSE: Home
(home, irrigation, municipal, industrial)

WELL COMPLETION DATA:
(1) diameter (inches) 4"
(2) total depth (feet) 145
(3) static water level (feet) 85 below above top of ground.
(4) casing plastic, 135,
(material) (depth)
4" If telescope see back.
(size)
(5) screen 10', 135
(length) (depth to top)
4", plastic
(size) (material)
(6) pump 3/4
(HP) (yield gpm)
elec.
(type power)
(7) electric log NO
(yes or no)
NO
(organization running log)
(8) how well bottom plugged
B.W. Value

DRILLERS REMARKS:

| description of formations encountered | from | to |
|---|---|---|
| Top Soil | 0 | 1 |
| Clay | 1 | 29 |
| Clay & Chalk | 29 | 95 |
| Sand & gravel | 95 | 135 |

CODED

RECEIVED
DEC 26 1974
MISS. BD. OF WATER COMM.

If well telescopes please sketch and show depths.

GROUND LEVEL

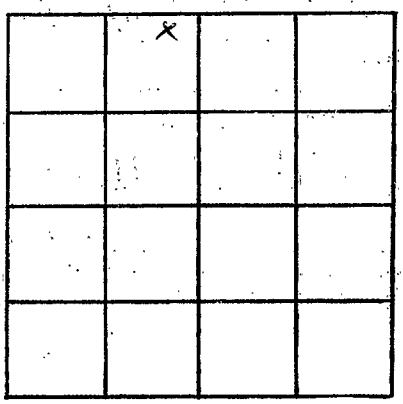


SECTION

Please indicate well location X.

ADDITIONAL INFORMATION

If more than one screen, show locations of each on sketch.