

WARREN

E

WATER WELL DRILLERS LOG

E 300

Date: 5/16, 1961, Driller: D H Williams County Warren

(Name)

(1) Owner of Land: J. F. Lott (Name)  
 Redwood Miss (Address)

(2) Location: 1/4, 1/4, Sec. T R  
 1 1/2 miles West of Kings (distance) (direction) (Nearest Town)

(3) Topography: 4 Miles North Vicksburg (Hilly) (Flat) (Level) Delta

(4) Purpose of Well: Home Use (Domestic Irrigation, Municipal, Industrial, Other)

Description & Color of Materials Sand, Clay, Red Clay, Shell, etc.	Thick- ness Feet	Depth Feet
1 to 35 Block Gravel	35	35
35 to 45 Blue Gravel or shale	10	45
45-75 Silt & fine Sand Note: much water	30	75
75 to 85 Hard Blue Shale	10	85
85 to 105 Fine Sand	30	115
115-140 Sand & Gravel	25	140
140 to 150 Fine Sand	10	150

Information upon completion of well:

(1) Diameter 4 1/2" Hole 2" inches. Casing

(2) Total Depth 150 feet.

(3) Water Level 20 ft feet below top of ground.


(4) Cased to 126', Size 2"

(5) Screen: Size 2", Length 10 ft.

(6) Were any formations sealed against pollution?  
 yes,  no.

If YES depth of formation Cemented 8 ft  
 from Top with 16" x 8" Cap Cement  
 Why Keep surface water out of well

Drillers Remarks: Set 10' 2" Strainer  
 from 126 to 136  
 3/4 HP - Jet Pump =

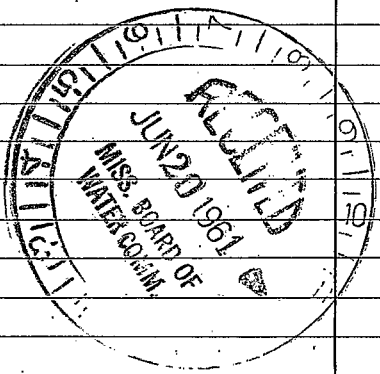

(Use Back Side)

Well No.

1877

1878

