MISSISSIPPI DEPARTMENT OF ENVIRONMENTAL QUALITY
Office of Land and Water Resources

P. O. Box 10631
Jackson, MS 39289-0631
WATER WELL DRILLERS LOG

COUNTY WELL LOCATED	Warren
WELL NUMBER	G
CODED	
	2000
DATE WELL COMPLETED	9-19-94
PERMIT NUMBER	0-60
NAME OF DRILLING FIRM	Rayburn Drilling Natchez, MS

NAME & MAILING ADDRESS OF LANDOWNER
Raymond Joyner
1204 Market St.
Port Gibson, MS.

WELL LOCATION: SEC 17 TOWNSHIP 17 N/S RANGE 5 E/W

DISTANCE 2 Miles DIRECTION North of NEAREST TOWN Vicksburg

OTHER LANDMARK

WELL PURPOSE: Home, Irrigation, Municipal, Industrial, Fish Pond, etc.
Home

PUMP DATA

PUMP TYPE (Circle One): Submersible, Turbine, Jet Flowing Well, Other (Describe)

POWER TYPE (Circle One): Electric, Tractor, Diesel, Gasoline, Butane, Other (Describe) 1½ H/P

Pump Capacity (GPM)	No. of Stages	Setting Depth
		FT.

PUMP TEST

Well yielded _____ GPM with a drawdown of _____ ft. after _____ hours of pumping

WELL DATA

Well Depth	Casing Diameter (In.)	Casing Length (Ft.)
128'	4"	118'

Type of Casing	Hole Depth	Depth to Static Water Level
PVC	128'	100'

TYPE OF COMPLETION: (Circle One or More): Gravel Packed, Underreamed, Telescoped, Natural Development, Open Hole, Other (Describe)

WELL GROUTED TO A DEPTH OF _____ FEET
Type Grout (circle one): Cement, Bentonite, or Mix

LOG DATA

TYPE OF LOG RUN (Circle One): No Log Run, Electric, Gamma Ray, Density, Sonic, Neutron, Other (Describe)

Name of Organization Running Log

GEOLOGIC DATA (Office Use Only)

Surface Elev.	Geologic Unit	Unit Thickness	Depth to Top
Subs. SWL	Date	Analysis	Aquifer Test

Driller's Remarks

Top of Lap Pipe or Reduction in Casing
FEET — IF TELESCOPED OR MORE THAN ONE SCREEN: USE BACK PAGE

SCREEN DATA

Diameter - Inches	Length - Feet	Slot Size - Inches
4"	10	.016

Screen Type	Depth to Bottom - Feet
SCH 40 PVC	128'

DESCRIPTION OF FORMATIONS ENCOUNTERED	FROM	TO
Top Soil	0	2
Chalk	2	80
Sand	80	95
Chalk	95	97
Pea Gravel	97	128'

FORMATIONS (Continued)	FROM	TO

RECEIVED
SEP 30 1994
Dept. of Environmental Quality
Office of Land & Water Resources

IF MORE SPACE IS NEEDED, USE BACK

If well telescopes please
sketch and show depths.

GROUND LEVEL

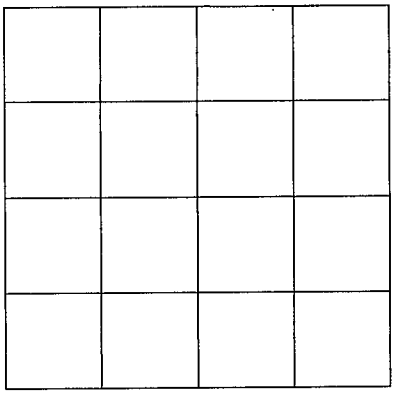

SECTION _____

Please indicate well location X.

ADDITIONAL INFORMATION

If more than one screen,
show location of each on sketch.