

04 7/29/69

WATER WELL DRILLERS LOG

Warren
L 10
-64

Date: Jan, 1964, Driller: David Benny County Warren
(Name)

(1) Owner of Land: L. V. Walker
(Name)
Bonnie Min
(Address)
2106 S

(2) Location: 1/4, 1/4, Sec. T R R
_____ miles _____ of _____
(distance) (direction) (Nearest Town)

(3) Topography: _____
(Hilly) (Flat) (Level)

(4) Purpose of Well: _____
(Domestic Irrigation
Municipal, Industrial, Other)

Description & Color of Materials Sand, Clay, Red Clay, Shell, etc.	Thick- ness Feet	Depth Feet
<u>Clay</u>	<u>38</u>	<u>38</u>
<u>Sand</u>	<u>12</u>	<u>60</u>
<u>Clay</u>	<u>9</u>	<u>69</u>
<u>Sand with clay</u>	<u>38</u>	<u>107</u>
<u>gravel</u>	<u>7</u>	<u>114</u>
<u>Sand gums</u>	<u>46</u>	<u>160</u>
<u>Sand shale</u>	<u>2</u>	<u>162</u>
<u>Sand</u>	<u>39</u>	<u>201</u>

Information upon completion of well:

(1) Diameter 4 inches.

(2) Total Depth 201 feet.

(3) Water Level 140 feet below top of ground.


(4) Cased to 81, Size 4

(5) Screen: Size 2", Length 20

(6) Were any formations sealed against pollution?
_____ yes, _____ no.

If YES depth of formation _____
Why _____

Drillers Remarks: _____

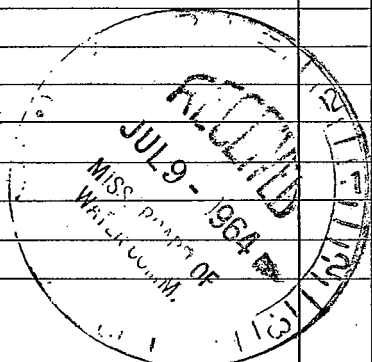

(Use Back Side)

Well No.





