County: Warren
Permit #:
Driller: Gary Rayborn
Date drilling completed: 6/27/13

STATE WELL REPORT
Part 1
Driller's Log

Mississippi Department of Environmental Quality
Office of Land and Water Resources
P.O. Box 2309
Jackson, MS 39225-2309
(601)961-5210
(601)360-0535 (fax)

For Office Use Only:
Well #: C15
Aquifer:
E-Log #:

State Law requires that this report be prepared by the license holder responsible for the work and filed with the Department at the above address within 30 days of completion of drilling of the well or borehole.

Well Owner Information
(Landowner if borehole is not for a water well)

Owner Name: James Reed
Mailing Address: 65904 SR 124
Reedsville OH 45772
City State Zip Code
Telephone No. (937) 452-3729

Well or Borehole Location

Latitude: ~~32° 20' 30"~~ 17 42 N Longitude: ~~90° 46' 12"~~ 43 27 W
Method of Lat/Long (*check one*): Conventional Survey____, USGS quad____, Hand-held GPS____, Survey-grade GPS____
SE ¼ NE ¼, Sec 98 T 15N R 5E
4 Miles S/SE of Bovina
(*Distance*) (*Direction*) (*Nearest Town*)

Well / Borehole Data

Date drilling started: 6/27/13 Date drilling completed: 6/27/13 Hole depth: 80' Hole diameter: 4"
Location of the source of any surface water used for drilling: —
Method of dosing and volume of Chlorine used in drilling and development: —
Logs run (*circle all applicable*): (No log run) Electric Gamma Ray Density Sonic Neutron Other:
Name of organization running log(s):
Purpose of borehole (*circle one*): (Water Well) Geotechnical/Geological Investigation Ground Source Heat Pump Seismic Survey Other (*describe*)

If drilling is not related to water well construction, skip the remainder of this block

RECEIVED
JUL 17 2013
BY: OLWR

Purpose of Well (*circle all applicable*): (Home) Industrial Public Supply Irrigation Fish Culture
Other (*describe*):
If a flowing well, method of flow regulation: Valve ____ Other (*describe*)
Static Water Level: 45 feet [above or (below)] land surface (*circle one*) Date measured: 6-27-13
Method of measurement (*circle one*): Steel tape (Electric tape) Air line Other (*describe*):
Well depth: 80' Well grouted to a depth of: 10 feet Type of grout (*circle one*): (Neat Cement) Bentonite Mix
Casing length: 60 feet Casing diameter: 4" inches Type of casing: PVC
Screen length: 20 feet Screen diameter: 4" inches Type of screen: PVC
Screen slot size: 010 inches Setting depth: From 60 feet to 80 feet
Type of completion (*circle all applicable*): (Gravel packed) Underreamed Open hole Natural Development
Other (*describe*):
Top of lap pipe or reduction in casing: ____ feet

If telescoped or more than one screen, describe on next page

Form: OLWR-SWR-1A (4/13)

County: Warren

Permit #:

For Office Use Only:

Well #: C15

The sketch below only required for water wells

If well telescopes, show depths on sketch.

Ground Level

RECEIVED
JUL 17 2013
BY: OLWR

If more than one screen, show location of each on sketch

Description of formations encountered must be provided for all wells and boreholes, unless specifically exempted by regulations

Description of Formations Encountered	From (*depth*)	To (*depth*)
Clay	Ground level	40
Fine Sand	40	50
Pea Gravel	50	80

Sketch the property layout and include the following:
1) the well location
2) any permanent structures on the property that may aid in locating the well
3) any roads, power lines, or other items that may aid in locating the property and the well
4) north arrow

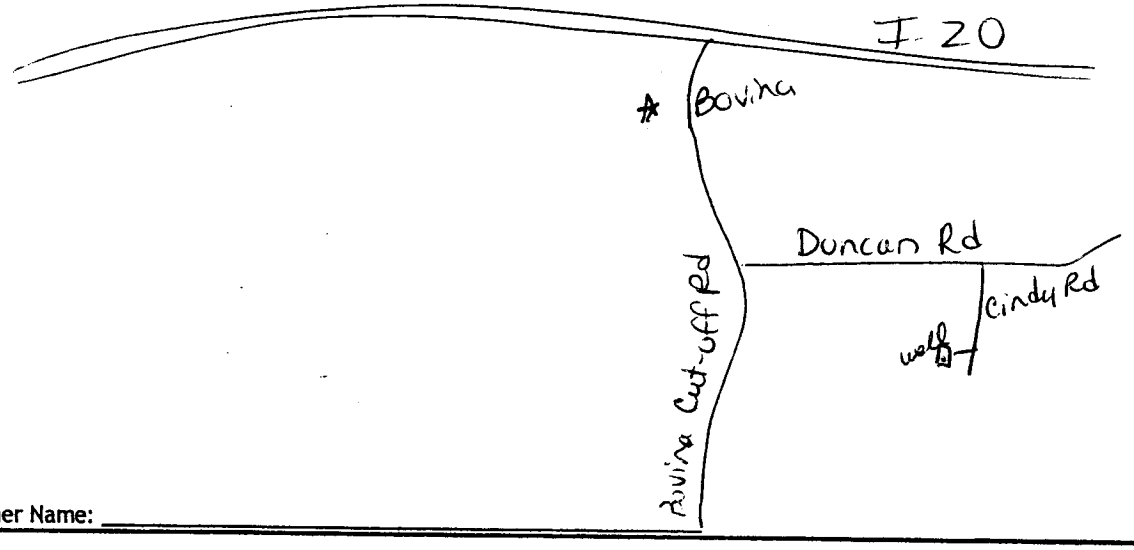

Landowner Name:

I HEREBY CERTIFY that the well/borehole was drilled, constructed, and completed in accordance with all applicable requirements of the Mississippi Department of Environmental Quality and the Mississippi Department of Health regulations, if applicable, and state laws.

Gary Rayborn 0-60 — Print Name of Responsible Licensee and License No.

7/15/13 — Date

Signature of Licensee

Form: OLWR-SWR-1A (*4/13*)

STATE WELL REPORT

County: Warren
Permit #:
Driller: Gary Rayborn
Date completed: 6-27-13
Copy information from block on Part 1

Part 2
Pump Installer's Completion Report

Mississippi Department of Environmental Quality
Office of Land and Water Resources
P.O. Box 2309
Jackson, MS 39225-2309
(601)961-5210
(601) 360-0535 (fax)

For Office Use Only:
Well #: C15
Aquifer:

This part of the report must be completed by a licensed water well contractor or a licensed pump installer. A copy of Part 1 of the report must be attached and both parts filed with the Department at the above address within 30 days of well completion.

Well Owner Information

Owner Name: James Reed
Mailing Address: 65904 CR 124
Reedsville OH 45772
City State Zip Code
Telephone No. (937) 452-3729

Well Location

Latitude: 32° 30' 30" N Longitude: 90° 46' 12" W
Method of Lat/Long (*check one*): Conventional Survey____, USGS quad____, Hand-held GPS____, Survey-grade GPS____
____ ¼ ____ ¼, Sec 9 T 15N R 5E
4 Miles S/SE of Bovina
(Distance) (Direction) (Nearest Town)

Pump Type (*circle one*)

Submersible Turbine Air Lift Centrifugal Flowing Well Jet Piston Rotary Other (*describe*):
Date Pump Installed: 6/27/13 Rated Pump Capacity: 35 GPM Gallons Per Minute
Is This Pump (*circle one*): New Repaired Replacement

Power Type (*circle one*)

Electric Diesel Gasoline Natural Gas Tractor PTO Windmill Other (*describe*):
Horse Power Rating of Motor: 1.5 Setting Depth: 63 feet Number of Stages: 11

Pump Test Data for Non Flowing Well

Date Well Tested: 6/27/13 Duration of Pump Test (*minimum 4 hours*): — hours
Static Water Level (A): 45 Feet Below Land Surface Pumping Water Level (B): — Feet Below Land Surface
Drawdown [(B) - (A)]: — Feet Below Land Surface Test Pumping Rate: 35 Gallons Per Minute
Method of measurement (*circle one*): Steel tape Electric tape Air line Other (*describe*):

Pump Test Data for Flowing Well

Measured shut in head: ____ feet.
Well yielded ____ GPM with a drawdown of ____ feet after ____ hours of pumping

RECEIVED
JUL 7 2013
BY: OLWR

Meter Installation

Meter Manufacturer: Meter Serial Number:
Meter Model Number/Name: Type of Meter:
Totalizer Register Unit and Multiplier Factor (AF x .001, gal x 1000, etc):
Installation Date: Meter installed by:
Is This Meter (*circle one*): New Repaired Replacement

Important: By submitting the above information you are certifying that this meter was installed to manufacturer standards. For agricultural wells, a list of approved meters is on the MDEQ website.

I HEREBY CERTIFY that the above statements are true to the best of my knowledge.

Gary Rayborn O-60 7/15/13
Print Name of Pump Installer and License No. (*if applicable*) Date Signature of Pump Installer

Form: OLWR-SWR-1B (*4/13*)