WARREN
R 21 17
3-20-69

MISSISSIPPI
BOARD OF WATER COMMISSIONERS
416 North State Street
Jackson, Mississippi 39201

CODED

WATER WELL DRILLERS LOG

3-20-69 19 DAVID BERRY WARREN
date well completed — firm name — county well located

LANDOWNER: R. G. LeTourneau
Vicksburg, Miss.
(mailing address)

WELL LOCATION:
sec. 49 T 14 N/S R 3 E/W
4 (distance) miles S (direction) of Vicksburg (nearest town)

WELL PURPOSE: INDUSTRIAL
(home, irrigation, municipal, industrial)

WELL COMPLETION DATA:
(1) diameter (inches) 8"
(2) total depth (feet) 96'
(3) static water level (feet) 25 below ~~above~~ top of ground.
(4) casing Steel (material), 73 ft (depth), 8" (size) if telescope see back.
(5) screen 20' (length), 73 ft (depth to top), 8" (size), Stainless (material)
(6) pump 5 (HP) 150 (yield gpm)
440 Vol Elec. (type power)
(7) electric log No (yes or no)
(organization running log)
(8) how well bottom plugged 24 Gluy

DRILLERS REMARKS:

description of formations encountered	from	to
Lime	0	60
Sand	60	96

FEB 16 1970
MISS. BD. OF WATER COMMS.

(1)

If well telescopes please sketch and show depths.

GROUND LEVEL

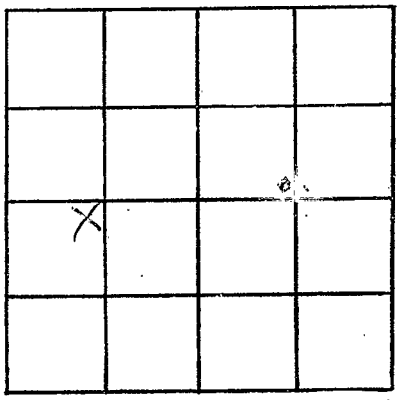

SECTION 49

Please indicate well location X.

ADDITIONAL INFORMATION

If more than one screen, show locations of each on sketch.