

Warren

MISSISSIPPI BOARD OF WATER COMMISSIONERS

R 2001

9-66

WATER WELL DRILLERS LOG

Inc.

Date: Sept. 20, 1966, Driller: Burney Water Well Service, Warren County

(Name)

(1) Owner of Land: Alfred Rollison

(Name)

Route 2, Box 179-A

Vicksburg (Address)

(2) Location: SW 1/4, 1/4, Sec. 28 T14R2E

12 miles South of Vicksburg

(distance) (direction) (Nearest Town)

on Old Park Davis Academy Road

(3) Topography: Hilly

(Hilly) (Flat) (Level)

(4) Purpose of Well: Domestic

(Domestic Irrigation, Municipal, Industrial, Other)

Description & Color of Materials Sand, Clay, Red Clay, Shell, etc.	Thick- ness Feet	Depth Feet
Brown top soil	38	38
Grey Clay layers	12	50
Blue Clay	9	59
Lime stone or rock	3	62
Blue clay	12	74
Rock or Limestone	8	82
Blue or brown clay	8	90
Short sand layers	6	96
Rock in layers	15	111
Sand layers	3	114
Blue shale	24	138
Sand layers	5	143
All fine sand	22	165

Information upon completion of well:

(1) Diameter 4 inches.

(2) Total Depth 165 feet.

(3) Water Level 96 feet below top of ground.

(4) Cased to 148', Size 2"

(5) Screen: Size 2", Length 5'


(6) Were any formations sealed against pollution?

X yes, no.

If YES depth of formation From Surface

Why to prevent surface pollution

Drillers Remarks: Sanitary Well seal used

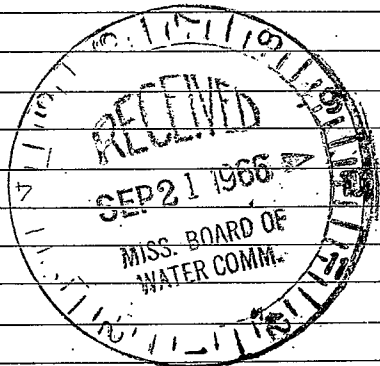

(Use Back Side)

Well No.

1911




