MISSISSIPPI DEPARTMENT OF ENVIRONM QUALIT
Office of Land and Water Resources

P. O. Box 10631
Jackson, MS 39289-0631

WATER WELL DRILLERS LOG

COUNTY WELL LOCATED: WARREN	
WELL NUMBER: 52003	CODED:
DATE WELL COMPLETED: 10-20-99	
PERMIT NUMBER:	
NAME OF DRILLING FIRM: EM. BUD CRESSWELL	
BENTONIA, MS.	

NAME & MAILING ADDRESS OF LANDOWNER:
GREY FERRISS
VICKSBURG, MS.

WELL LOCATION	SEC	TOWNSHIP	RANGE
	29	14 N	4 E

DISTANCE	DIRECTION	NEAREST TOWN
10 Miles	SOUTH of	VICKSBURG

OTHER LANDMARK:

WELL PURPOSE: Home, Irrigation, Municipal, Industrial, Fish Pond, etc.

PUMP DATA

PUMP TYPE (Circle One): Submersible, Turbine, Jet, Flowing Well, Other (Describe) _____

POWER TYPE (Circle One): Electric, Tractor, Diesel, Gasoline, / Butane, Other (Describe) _____ H/P _____

Pump Capacity (GPM)	No of Stages	Setting Depth
20	10	45 FT.

PUMP TEST

Well yielded 30 GPM with a drawdown of 10 ft. after 1/2 hours of pumping

WELL DATA

Well Depth	Casing Diameter (In.)	Casing Length (Ft.)
50	4	40

Type of Casing	Hole Depth	Depth to Static Water Level
PVC	50	25

TYPE OF COMPLETION: (Circle One or More): Gravel Packed, Underreamed, Telescoped, Natural Development, Open Hole, Other (Describe) _____

WELL GROUTED TO A DEPTH OF 25 FEET
Type Grout (circle one): Cement, Bentonite, or Mix

LOG DATA

TYPE OF LOG RUN (Circle One): No Log Run, Electric, Gamma Ray, Density, Sonic, Neutron, Other (Describe) _____

Name of Organization Running Log

GEOLOGIC DATA (Office Use Only)

Surface Elev	Geologic Unit	Unit Thickness	Depth to Top
Subs. SWL	Date	Analysis	Aquifer Test

Driller's Remarks

SCREEN DATA

Diameter - Inches	Length - Feet	Slot Size - Inches
4	10	.016

Screen Type	Depth to Bottom - Feet
PVC	50

Top of Lap Pipe or Reduction in Casing
FEET

IF TELESCOPED OR MORE THAN ONE SCREEN: USE BACK PAGE

DESCRIPTION OF FORMATIONS ENCOUNTERED	FROM	TO
SURFACE DEPOSITS	0	20
SAND	20	50

FORMATIONS (Continued) FROM TO

NOV 03 1999
Dept. of Environmental Quality
Office of Land & Water Resources

IF MORE SPACE IS NEEDED, USE BACK

If well telescopes please sketch and show depths.

GROUND LEVEL

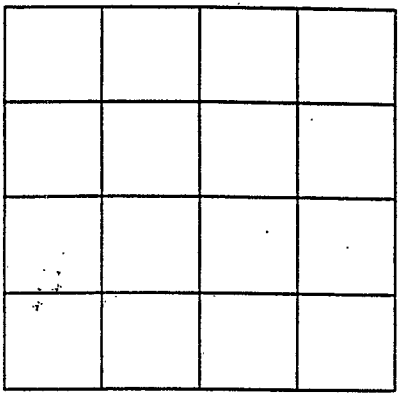

SECTION _____

Please indicate well location X.

ADDITIONAL INFORMATION

If more than one screen, show location of each on sketch.