MISSISSIPPI DEPARTMENT OF ENVIRONMENTAL QUALITY
Office of Land and Water Resources

P. O. Box 10631
Jackson, MS 39289-0631
WATER WELL DRILLERS LOG

COUNTY WELL LOCATED: Washington	
WELL NUMBER: A 152	CODED:
DATE WELL COMPLETED: 8-15-00	
PERMIT NUMBER:	
NAME OF DRILLING FIRM: Schutco LLC	

NAME & MAILING ADDRESS OF LANDOWNER
Wanda Williamson
2110 Hwy 1 No.
Greenville MS 38701

WELL LOCATION: SEC 29 TOWNSHIP 19 (N) S RANGE 8 E (W)

DISTANCE 3 Miles DIRECTION North of NEAREST TOWN Greenville

OTHER LANDMARK

WELL PURPOSE: (Home) Irrigation, Municipal, Industrial, Fish Pond, etc.

PUMP DATA

PUMP TYPE (Circle One): (Submersible), Turbine, Jet, Flowing Well, Other (Describe)

POWER TYPE (Circle One): (Electric), Tractor, Diesel, Gasoline, Butane, Other (Describe) H/P 3

Pump Capacity (GPM)	No. of Stages	Setting Depth
50		105 FT.

PUMP TEST

Well yielded _____ GPM with a drawdown of _____ ft. after _____ hours of pumping

WELL DATA

Well Depth	Casing Diameter (In.)	Casing Length (Ft.)
520	4X3	490

Type of Casing	Hole Depth	Depth to Static Water Level
pvc	540	

TYPE OF COMPLETION: (Circle One or More): Gravel Packed, Underreamed, Telescoped, (Natural Development), Open Hole, Other (Describe)

WELL GROUTED TO A DEPTH OF 10 FEET
Type Grout (circle one): (Cement), Bentonite, or Mix

LOG DATA

TYPE OF LOG RUN (Circle One): (No Log Run), Electric, Gamma Ray, Density, Sonic, Neutron, Other (Describe)

Name of Organization Running Log

GEOLOGIC DATA (Office Use Only)

Surface Elev.	Geologic Unit	Unit Thickness	Depth to Top
Subs. SWL	Date	Analysis	Aquifer Test

Driller's Remarks

SCREEN DATA

Diameter - Inches	Length - Feet	Slot Size - Inches
3	30 ft	.008

Screen Type	Depth to Bottom - Feet
pvc	520

Top of Lap Pipe or Reduction in Casing
FEET
IF TELESCOPED OR MORE THAN ONE SCREEN: USE BACK PAGE

DESCRIPTION OF FORMATIONS ENCOUNTERED	FROM	TO	FORMATIONS (Continued)	FROM	TO
Gumbo	0	60			
Course sand + gravel	60	120			
clay	120	380			
shell	380	480			
sand	480	520			
shell	520	540			
			IF MORE SPACE IS NEEDED, USE BACK		

REC'D JUN 14 2001

If well telescopes please sketch and show depths.

GROUND LEVEL

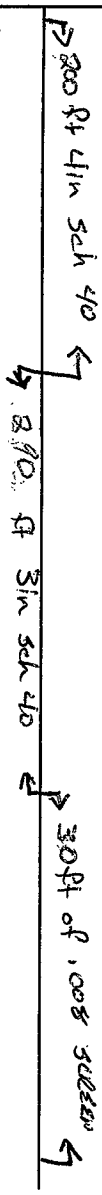

If more than one screen, show location of each on sketch.

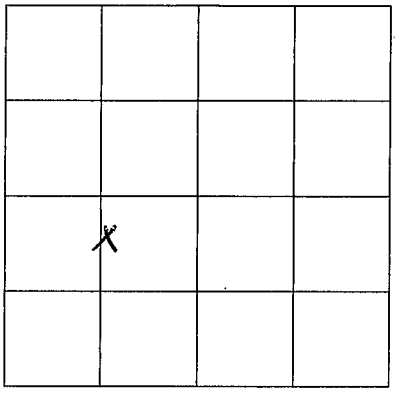

SECTION 29

Please indicate well location X.

ADDITIONAL INFORMATION