WASHINGTON
C 33
3/1/78
MS-GW 4570

MISSISSIPPI
BOARD OF WATER COMMISSIONERS
416 North State Street
Jackson, Mississippi 39201

CODED

WATER WELL DRILLERS LOG

March 1 1978 Dyer Well & Irrigation Washington
date well completed — firm name — county well located

LANDOWNER Curtis Land & Farming Co.
602 S.W. Deer Creek Dr.
Leland, Miss. 38756
(mailing address)

WELL LOCATION:
sec. 17 T 19 (N) S R 6 E (W)
5 miles North of Elizabeth
(distance) (direction) (nearest town)

WELL PURPOSE: Irrigation
(home, irrigation, municipal, industrial)

WELL COMPLETION DATA:
(1) diameter (inches) 16"
(2) total depth (feet) 113'
(3) static water level (feet) 18' below above top of ground.
(4) casing Steel (material), 73' (depth), 16" (size) if telescope see back.
(5) screen 40' (length), 73' (depth to top), 16" (size), Steel (material)
(6) pump 40 (HP) 2,000 (yield gpm)
Diesel (type power)
(7) electric log No (yes or no)
(organization running log)
(8) how well bottom plugged Plate

DRILLERS REMARKS:

description of formations encountered	from	to
Clay CODED	0	13
Clay	14	23
Clay	24	31
Fine Sand	32	43
Fine Sand	44	53
Fine Sand	54	59
Sand & Gravel	60	113
Bottom 113'		

Miss. Board of Water Comm.
FEB 8 1979
RECEIVED

If well telescopes please sketch and show depths.

GROUND LEVEL

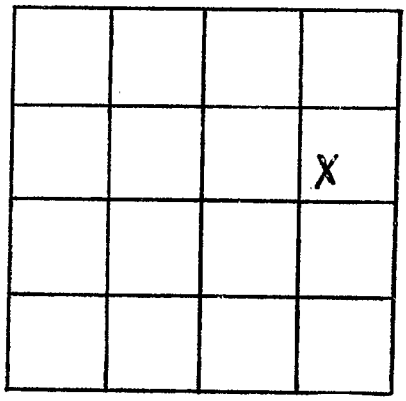

SECTION 17

Please indicate well location X.

ADDITIONAL INFORMATION

If more than one screen, show locations of each on sketch.