MISSISSIPPI DEPARTMENT OF ENVIRONMENTAL QUALITY

Office of Land and Water Resources

P. O. Box 10631
Jackson, MS 39289-0631

WATER WELL DRILLERS LOG

COUNTY WELL LOCATED	Washington
WELL NUMBER	C
CODED	30156
DATE WELL COMPLETED	7-27-93
PERMIT NUMBER	
NAME OF DRILLING FIRM	IRRIGATION EQUIPMENT
	601/887-2555
	INDIANOLA, MS

NAME & MAILING ADDRESS OF LANDOWNER
Gus + Jeff Pieralisi Farms
Rt. 2, BOX 67
Leland, MS 38756

WELL LOCATION:	SEC	TOWNSHIP	RANGE
SE/NE	15	19 (N) S	6 E (W)

DISTANCE	DIRECTION	NEAREST TOWN
8 Miles	NE	of Leland

OTHER LANDMARK

WELL PURPOSE: Home, Irrigation, Municipal, Industrial, Fish Pond, etc.
Irrigation - Pivot

PUMP DATA

PUMP TYPE (Circle One): Submersible, (Turbine), Jet, Flowing Well, Other (Describe) _____

POWER TYPE (Circle One): Electric, Tractor, (Diesel), Gasoline, Butane, Other (Describe) _____ H/P 60

Pump Capacity (GPM)	No. of Stages	Setting Depth
1000	2	50 FT.

PUMP TEST

Well yielded _____ GPM with a drawdown of _____ ft. after _____ hours of pumping

WELL DATA

Well Depth	Casing Diameter (In.)	Casing Length (Ft.)
106	12	66

Type of Casing	Hole Depth	Depth to Static Water Level
Steel	106	19'

TYPE OF COMPLETION: (Circle One or More): (Gravel Packed), Underreamed, Telescoped, Natural Development, Open Hole, Other (Describe) _____

WELL GROUTED TO A DEPTH OF _____ FEET
Type Grout (circle one): Cement, Bentonite, or Mix

LOG DATA

TYPE OF LOG RUN (Circle One): No Log Run, Electric, Gamma Ray, Density, Sonic, Neutron, Other (Describe) _____

Name of Organization Running Log

GEOLOGIC DATA (Office Use Only)

Surface Elev.	Geologic Unit	Unit Thickness	Depth to Top
Subs. SWL	Date	Analysis	Aquifer Test

Driller's Remarks
Big-D

SCREEN DATA

Diameter - Inches	Length - Feet	Slot Size - Inches
12	40	.060

Screen Type	Depth to Bottom - Feet
Steel	106

DESCRIPTION OF FORMATIONS ENCOUNTERED	FROM	TO
Fine Sand	0	3
medium Sand	3	35
Coarse Sand	35	106

FORMATIONS (continued)	FROM	TO

RECEIVED
AUG 17 1993
Dept. of Environmental Quality
Office of Land & Water Resources

IF MORE SPACE IS NEEDED, USE BACK

If well telescopes please sketch and show depths.

GROUND LEVEL

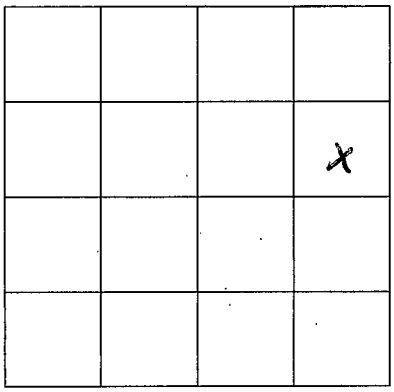

SECTION 15

Please indicate well location X.

ADDITIONAL INFORMATION

If more than one screen, show location of each on sketch.