WASH.
D 134
6-2-73

MISSISSIPPI
BOARD OF WATER COMMISSIONERS
416 North State Street
Jackson, Mississippi 39201

CODED

WATER WELL DRILLERS LOG

2 June 1973 Lambert Drilling Co Wash.
date well completed — firm name — county well located

LANDOWNER: Jack Hales
Hwy 82 E.
Greenville, Miss.
(mailing address)

WELL LOCATION:
sec. 8 T 18 N R 8 W
5 1/2 miles S E of Greenville
(distance) (direction) (nearest town)

WELL PURPOSE: home
(home, irrigation, municipal, industrial)

WELL COMPLETION DATA:

(1) diameter (inches) 2
(2) total depth (feet) 450
(3) static water level (feet) 48 below ~~above~~ top of ground.
(4) casing P.V.C (material), 435 (depth),
_____ (size) if telescope see back.
(5) screen 15' (length), 450-435 (depth to top)
2" (size), P.V.C. (material)
(6) pump 1 (HP) 10 (yield gpm)
Elect (type power)
(7) electric log _____ (~~yes~~ or no)
_____ (organization running log)
(8) how well bottom plugged
P.V.C. back wash valve

DRILLERS REMARKS:

description of formations encountered	from	to
Clay	0	32
Sand	32	65
Pea gravel	65	86
blue clay	86	110
blue shell	110	130
Clay & sandst	130	185
rock	185	187
Clay & sandst.	187	270
Rock	270	272
Clay & sandst	272	375
Sand fine	375	390
Sand fine	390	405
Sand	405	420
Sand good	420	460

CODED

JUN 20 1973
MISS. BD. OF WATER COMM

If well telescopes please sketch and show depths.

GROUND LEVEL

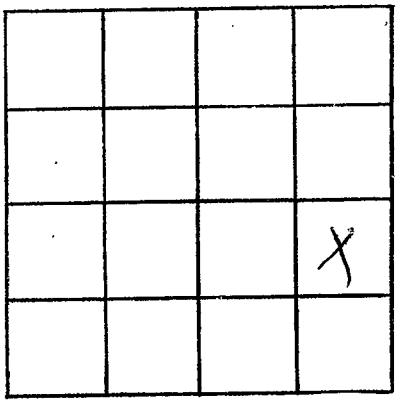

SECTION 8

Please indicate well location X.

ADDITIONAL INFORMATION

If more than one screen, show locations of each on sketch.