WASH.
D 155
1/13/78

MISSISSIPPI
BOARD OF WATER COMMISSIONERS
416 North State Street
Jackson, Mississippi 39201

CODED

WATER WELL DRILLERS LOG

1-13 19 78 — date well completed
Layne Central Co. — firm name
Washington — county well located

LANDOWNER: O & S Farm
P.O. Box 361
Greenville, MS 38701
(mailing address)

WELL LOCATION:
sec. 29 T 18 N R 8 W
2 miles SE of Greenville
(distance) (direction) (nearest town)

WELL PURPOSE: Irrigation
(home, irrigation, municipal, industrial)

WELL COMPLETION DATA:

(1) diameter (inches) 16"
(2) total depth (feet) 85'2"
(3) static water level (feet) 16' below top of ground.
(4) casing Steel (material), 51'10" (depth), 16" (size) if telescope see back.
(5) screen 30' (length), 55'2" (depth to top), 12" (size), St. Steel (material)
(6) pump 30 (HP) 800 (yield gpm) diesel (type power)
(7) electric log No (yes or no)
(organization running log)
(8) how well bottom plugged St.Plate

DRILLERS REMARKS:

description of formations encountered	from	to
Clay	0	20
Fine Sand	20	42
Med.Sand & Pea Gravel	42	55
Coarse Sand & Pea Gravel	55	72
Med.Sand, C.Sand & Pea Gravel	72	82
C. Sand & Pea Gravel	82	83
Rock	83	84

CODED

RECEIVED
MAR 14 1978
MISS. BD. OF WATER COMM.

If well telescopes please sketch and show depths.

GROUND LEVEL

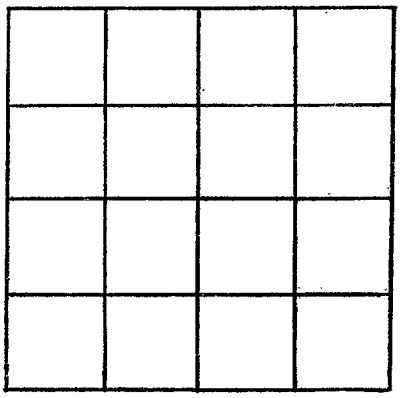

SECTION _____

Please indicate well location X.

ADDITIONAL INFORMATION

If more than one screen, show locations of each on sketch.