Washington
D 1021
1-18-80

MISSISSIPPI
BOARD OF WATER COMMISSIONERS
416 North State Street
Jackson, Mississippi 39201

WATER WELL DRILLERS LOG

18 Jan 1980 Lambert Drilling Wash
date well completed — firm name — county well located

LANDOWNER: Woodman of the World
Woodman Rd Greenville
(mailing address)

WELL LOCATION:
sec. 25 T 18 N S R 8 E W
3 1/2 miles SE of Greenville
(distance) (direction) (nearest town)

WELL PURPOSE: home
(home, irrigation, municipal, industrial)

WELL COMPLETION DATA:
(1) diameter (inches) 4X2
(2) total depth (feet) 380
(3) static water level (feet) 46 below above top of ground.
(4) casing PVC (material), 360 (depth),
4X2 (size) if telescope see back.
(5) screen 20 (length), 380-360 (depth to top)
2 (size), PVC (material)
(6) pump 1 (HP) 20 (yield gpm)
elect (type power)
(7) electric log _____ (yes or no)
_____ (organization running log)
(8) how well bottom plugged back press

DRILLERS REMARKS:

description of formations encountered	from	to
Clay	0	25
Sand.	25	60
Pea gravel	60	90
blue Shell	90	120
Clay st Sand	120	150
" "	150	265
Sand fine	265	285
Sand med	285	320
Sand good	320	400

DEPT. OF NATURAL RESOURCES
BUREAU OF LAND & WATER RESOURCES
MAY 27 1980
RECEIVED

If well telescopes please sketch and show depths.

GROUND LEVEL

140 4"

360 2"

380 2" Sc.

If more than one screen, show locations of each on sketch.

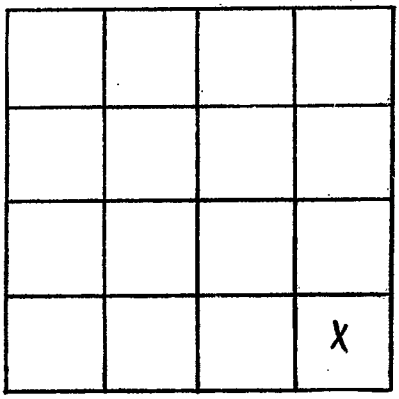

SECTION 25

Please indicate well location X.

ADDITIONAL INFORMATION