WASHINGTON
D 2009

MISSISSIPPI DEPARTMENT OF NATURAL RESOURCES

Bureau of Land and Water Resources
Southport Mall
P.O. Box 10631
Jackson, Mississippi 39209

WATER WELL DRILLERS LOG

6-15 1987 Schultz Drilling WASHINGTON
date well completed — firm name — county well located

LANDOWNER: DR. YARBROUGH
147 Bayou Rd.
Greenville Ms. 38701
(mailing address)

WELL LOCATION:
sec. 11 T 18 (N/S) R 8 (E/W)
1 miles SW of Greenville
(distance) (direction) (nearest town)

WELL PURPOSE: Home
(home, irrigation, municipal, industrial)

WELL COMPLETION DATA:

(1) diameter (inches) 4" X 2"
(2) total depth (feet) 500'
(3) static water level (feet) 38' below/above top of ground.
(4) casing PVC (material), 480' (depth),
_____ (size) if telescope see back.
(5) screen 20' (length), 480' (depth to top)
2" (size), PVC (material)
(6) pump 1½ (HP) 30 (yield gpm)
do (type power)
(7) electric log no (yes or no)
✓ (organization running log)
(8) how well bottom plugged b/w

DRILLERS REMARKS:

description of formations encountered	from	to
CLAY	0	15
SAND	15	88
CLAY + SHALE	88	400
SHALE	400	450
SAND	450	500

RECEIVED
OCT 05 1987
Department of Natural Resources
Bureau of Land & Water Resources

If well telescopes please sketch and show depths.

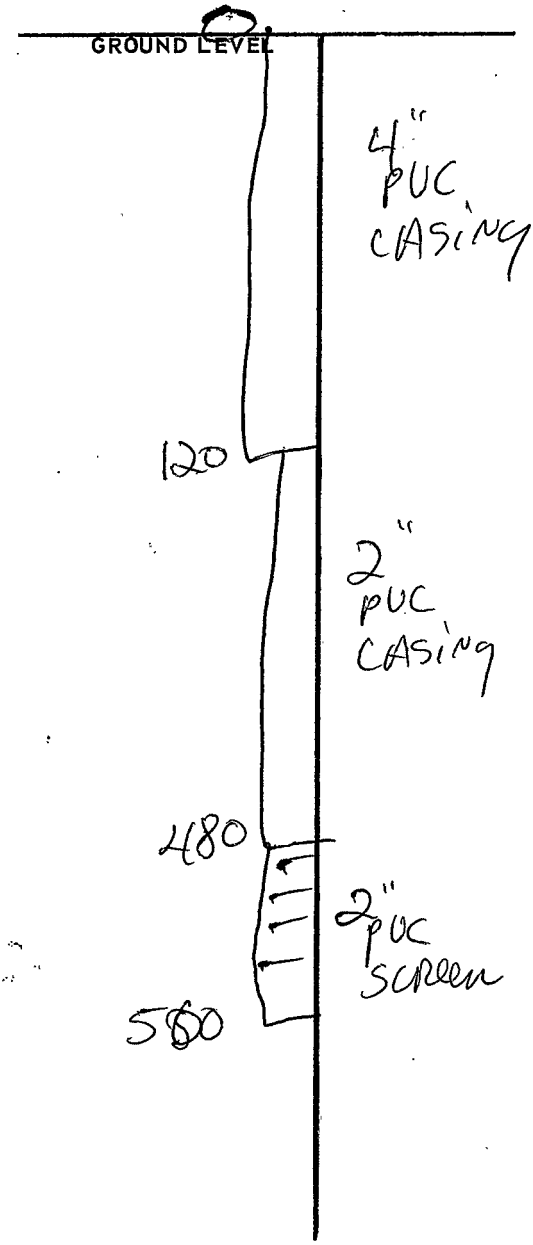

If more than one screen, show locations of each on sketch.

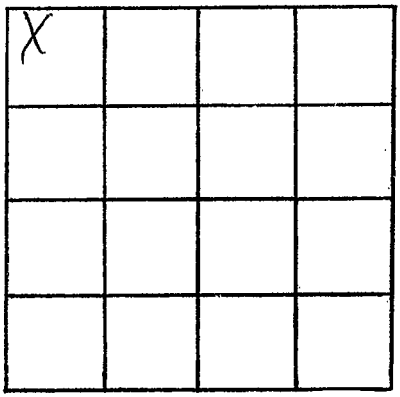

SECTION 11

Please indicate well location X.

ADDITIONAL INFORMATION