MISSISSIPPI DEPARTMENT OF ENVIRONMENTAL QUALITY
Office of Land and Water Resources

P. O. Box 10631
Jackson, MS 39289-0631
WATER WELL DRILLERS LOG

COUNTY WELL LOCATED: Washington	
WELL NUMBER: D2029	CODED:
DATE WELL COMPLETED: 10-20-99	
PERMIT NUMBER:	
NAME OF DRILLING FIRM: Schudco Ltd	

NAME & MAILING ADDRESS OF LANDOWNER
South Fork Homes
Greenville MS
Charles Frazier 38701

WELL LOCATION: SEC 15 TOWNSHIP 18 (N) S RANGE 8 E (W)

DISTANCE 2 Miles DIRECTION East of NEAREST TOWN Greenville

OTHER LANDMARK

WELL PURPOSE: Home, Irrigation, Municipal, Industrial, Fish Pond, etc.

PUMP DATA

PUMP TYPE (Circle One): Submersible, Turbine, Jet, Flowing Well, Other (Describe)

POWER TYPE (Circle One): Electric, Tractor, Diesel, Gasoline, Butane, Other (Describe) H/P 1

Pump Capacity (GPM)	No. of Stages	Setting Depth
20	7	105 FT.

PUMP TEST

Well yielded _____ GPM with a drawdown of _____ ft. after _____ hours of pumping

WELL DATA

Well Depth	Casing Diameter (In.)	Casing Length (Ft.)
450	4X2	430
Type of Casing	**Hole Depth**	**Depth to Static Water Level**
pvc	450	57

TYPE OF COMPLETION: (Circle One or More): Gravel Packed, Underreamed, Telescoped, Natural Development, Open Hole, Other (Describe)

WELL GROUTED TO A DEPTH OF 10 FEET
Type Grout (circle one): Cement, Bentonite, or Mix

LOG DATA

TYPE OF LOG RUN (Circle One): No Log Run, Electric, Gamma Ray, Density, Sonic, Neutron, Other (Describe)

Name of Organization Running Log

RECEIVED DEC 03 1999

GEOLOGIC DATA (Office Use Only)

Surface Elev.	Geologic Unit	Unit Thickness	Depth to Top
Subs. SWL	Date	Analysis	Aquifer Test

Driller's Remarks

Dept. of Environmental Quality
Office of Land & Water Resources

SCREEN DATA

Diameter - Inches	Length - Feet	Slot Size - Inches
2	20	.008
Screen Type		**Depth to Bottom - Feet**
pvc		450

DESCRIPTION OF FORMATIONS ENCOUNTERED	FROM	TO	FORMATIONS (Continued)	FROM	TO
Gumbo	0	34			
Sand - pg	34	85			
Clay & Shell	85	340			
Sand	340	450			
Rock	450				
			IF MORE SPACE IS NEEDED, USE BACK		

If well telescopes please sketch and show depths.

GROUND LEVEL

If more than one screen, show location of each on sketch.

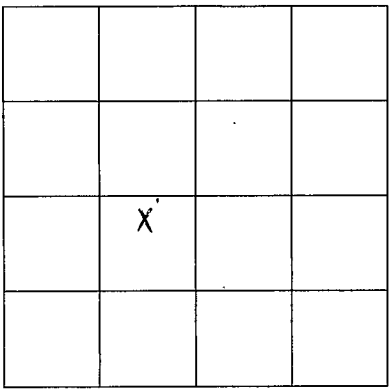

SECTION 15

Please indicate well location X.

ADDITIONAL INFORMATION