WASHINGTON
E102
12-7-79
MS-GW 4569

MISSISSIPPI
BOARD OF WATER COMMISSIONERS
416 North State Street
Jackson, Mississippi 39201

WATER WELL DRILLERS LOG

12/7 1979 — date well completed
Dyer — firm name
Wash. — county well located

LANDOWNER: MARK CURTIS
LELAND, MS.
(mailing address)

WELL LOCATION:
sec. 25 T 18 N (S) R 7 E (W)
4 miles N of Leland
(distance) (direction) (nearest town)

WELL PURPOSE:
(home, irrigation, municipal, industrial)

WELL COMPLETION DATA:
(1) diameter (inches) 16
(2) total depth (feet) 113'
(3) static water level (feet) 22' below above top of ground.
(4) casing Steel (material), 113' (depth), 16" (size) if telescope see back.
(5) screen 40' (length), 73' (depth to top), 16" (size), Steel (material)
(6) pump 60 (HP) 3000 (yield gpm) Diesel (type power)
(7) electric log (yes or no)
(organization running log)
(8) how well bottom plugged plate

DRILLERS REMARKS:

description of formations encountered CODED	from	to
Clay	0	24
Fine Sand	24	35
Sand	35	48
Sand & Gravel	48	113

CODED

MAR 1981 RECEIVED

If well telescopes please sketch and show depths.

GROUND LEVEL

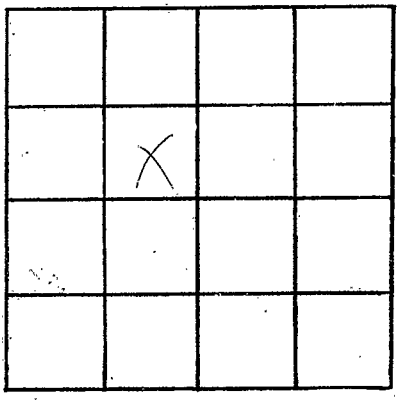

SECTION 7

Please indicate well location X.

ADDITIONAL INFORMATION

If more than one screen, show locations of each on sketch.