WASHINGTON
F 2021

MISSISSIPPI DEPARTMENT OF NATURAL RESOURCES

Bureau of Land and Water Resources
Southport Mall
P.O. Box 10631
Jackson, Mississippi 39209

WATER WELL DRILLERS LOG

8-11 19 86 Schultz Drilling WASHINGTON
date well completed — firm name — county well located

LANDOWNER: Emery Boehs
Hwy. 82 E
Leland, MS
(mailing address)

WELL LOCATION:
sec. 28 T 18 (N) (S) R 6 (E) (W)
5 miles SE of Leland
(distance) (direction) (nearest town)

WELL PURPOSE: HOME
~~(home,~~ irrigation, municipal, industrial)

WELL COMPLETION DATA:

(1) diameter (inches) 4" X 2"

(2) total depth (feet) 500'

(3) static water level (feet) 34' ~~below~~ above top of ground.

(4) casing PVC (material), 480 (depth),
(size) if telescope see back.

(5) screen 20' (length), 480' (depth to top)
2" (size), PVC (material)

(6) pump 1½ (HP) 35 (yield gpm)
ele (type power)

(7) electric log No (yes or no)
X (organization running log)

(8) how well bottom plugged b/w

DRILLERS REMARKS:

description of formations encountered	from	to
CLAY	0	20
SAND + PEA GRAVEL	20	80
GRAVEL	80	130
CLAY	130	210
SHALE	210	410
SAND	410	500

RECEIVED
OCT 01 1986
Department of Natural Resources
Bureau of Land & Water Resources

If well telescopes please sketch and show depths.

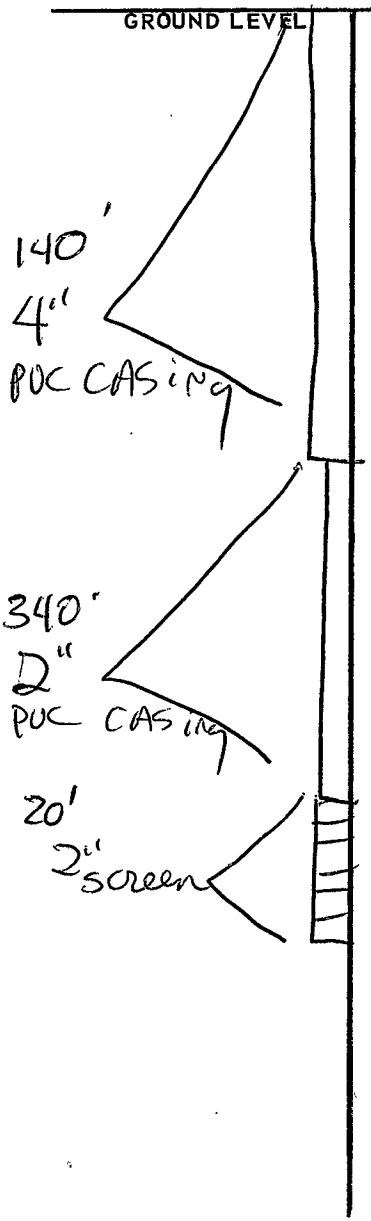

If more than one screen, show locations of each on sketch.

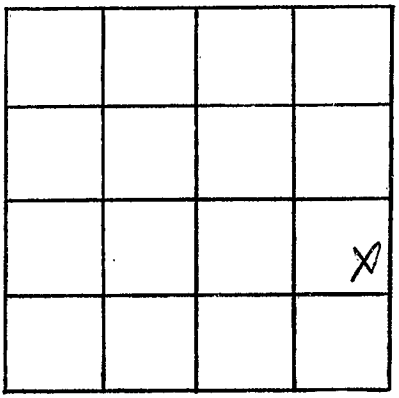

SECTION 28

Please indicate well location X.

ADDITIONAL INFORMATION