MISSISSIPPI DEPARTMENT OF ENVIRONMENTAL QUALITY
Office of Land and Water Resources

P. O. Box 10631
Jackson, MS 39289-0631
WATER WELL DRILLERS LOG

COUNTY WELL LOCATED	Washington
WELL NUMBER	F
CODED	
PERMIT NUMBER	
	2048
NAME OF DRILLING FIRM	IRRIGATION EQUIPMENT 601/887-2555 INDIANOLA, MS
DATE WELL COMPLETED	7-12-93

NAME & MAILING ADDRESS OF LANDOWNER
Triple C Farms
Rt. 2, Box L-44
Leland, MS 38756

WELL LOCATION:	SEC	TOWNSHIP	RANGE
NW/SE	16	18 (N) S	6 E (W)

DISTANCE	DIRECTION	NEAREST TOWN
3 Miles	East	of Leland

OTHER LANDMARK

WELL PURPOSE: Home, Irrigation, Municipal, Industrial, Fish Pond, etc.
Irrigation - Pivot

WELL DATA

Well Depth	Casing Diameter (In.)	Casing Length (Ft.)
115'	12	75

Type of Casing	Hole Depth	Depth to Static Water Level
Steel	115	21'

TYPE OF COMPLETION: (Circle One or More): Gravel Packed, Underreamed, Telescoped, Natural Development, Open Hole, Other (Describe) _____

WELL GROUTED TO A DEPTH OF _____ FEET
Type Grout (circle one): Cement, Bentonite, or Mix

SCREEN DATA

Diameter - Inches	Length - Feet	Slot Size - Inches
12	40	.060

Screen Type	Depth to Bottom - Feet
Steel	115

PUMP DATA

PUMP TYPE (Circle One): Submersible, Turbine, Jet, Flowing Well, Other (Describe) _____

POWER TYPE (Circle One): Electric, Tractor, Diesel, Gasoline, Butane, Other (Describe) _____ H/P 110

Pump Capacity (GPM)	No. of Stages	Setting Depth
1500	4	50 FT.

PUMP TEST

Well yielded _____ GPM with a drawdown of _____ ft. after _____ hours of pumping

LOG DATA

TYPE OF LOG RUN (Circle One): No Log Run, Electric, Gamma Ray, Density, Sonic, Neutron, Other (Describe) _____

Name of Organization Running Log

GEOLOGIC DATA (Office Use Only)

Surface Elev.	Geologic Unit	Unit Thickness	Depth to Top
Subs. SWL	Date	Analysis	Aquifer Test

Driller's Remarks
Big-D

DESCRIPTION OF FORMATIONS ENCOUNTERED	FROM	TO
Soil	0	5
Coarse Sand	5	65
Sand + Gravel	65	95
Gravel	95	115

FORMATIONS (Continued)	FROM	TO

RECEIVED
AUG 17 1993
Dept. of Environmental Quality
Office of Land & Water Resources

IF MORE SPACE IS NEEDED, USE BACK

If well telescopes please sketch and show depths.

GROUND LEVEL

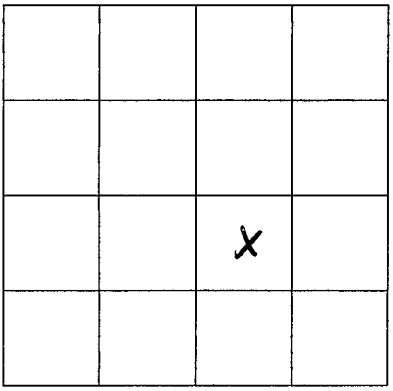

SECTION 16

Please indicate well location X.

ADDITIONAL INFORMATION

If more than one screen, show location of each on sketch.