MISSISSIPPI DEPARTMENT OF ENVIRONMENTAL QUALITY
Office of Land and Water Resources

P. O. Box 10631
Jackson, MS 39289-0631
WATER WELL DRILLERS LOG

COUNTY WELL LOCATED	Washington
WELL NUMBER	F 2061
CODED	
DATE WELL COMPLETED	5-17-98
PERMIT NUMBER	
NAME OF DRILLING FIRM	IRRIGATION EQUIPMENT 601/887-2555 INDIANOLA, MS

NAME & MAILING ADDRESS OF LANDOWNER:
Tim Zepponi
Rt. 2, Box 702
Leland, MS 38756

WELL LOCATION:	SEC	TOWNSHIP	RANGE
SE/SE	10	18 (N) S	6 E (W)

DISTANCE	DIRECTION	NEAREST TOWN
5 Miles	EAST of	Leland

OTHER LANDMARK:

WELL PURPOSE: Home, Irrigation, Municipal, Industrial, Fish Pond, etc.
Irrigation

PUMP DATA

PUMP TYPE (Circle One): (Submersible), Turbine, Jet, Flowing Well, Other (Describe) _____

POWER TYPE (Circle One): (Electric), Tractor, Diesel, Gasoline, Butane, Other (Describe) _____ H/P 15

Pump Capacity (GPM)	No. of Stages	Setting Depth
750	1	60 FT.

PUMP TEST

Well yielded _____ GPM with a drawdown of _____ ft. after _____, hours of pumping

WELL DATA

Well Depth	Casing Diameter (In.)	Casing Length (Ft.)
115	10	80

Type of Casing	Hole Depth	Depth to Static Water Level
PVC	115	21 ft.

TYPE OF COMPLETION: (Circle One or More): (Gravel Packed), Underreamed, Telescoped, Natural Development, Open Hole, Other (Describe) _____

WELL GROUTED TO A DEPTH OF _____ FEET
Type Grout (circle one): Cement, Bentonite, or Mix

LOG DATA

TYPE OF LOG RUN (Circle One): No Log Run, Electric, Gamma Ray, Density, Sonic, Neutron, Other (Describe) _____

Name of Organization Running Log

GEOLOGIC DATA (Office Use Only)

Surface Elev.	Geologic Unit	Unit Thickness	Depth to Top
Subs. SWL	Date	Analysis	Aquifer Test

Driller's Remarks

SCREEN DATA

Diameter - Inches	Length - Feet	Slot Size - Inches
10	35	.050

Screen Type	Depth to Bottom - Feet
PVC	115

Top of Lap Pipe or Reduction in Casing
FEET

IF TELESCOPED OR MORE THAN ONE SCREEN: USE BACK PAGE

DESCRIPTION OF FORMATIONS ENCOUNTERED	FROM	TO	FORMATIONS (Continued)	FROM	TO
clay	0	15			
Fine sand	15	35			
Fine sand & Gravel	35	65			
med. sand & Gravel	65	94			
Fine sand	94	100			
med. sand & Gravel	100	115			
			06-19-98A09:42 RCVD		
			IF MORE SPACE IS NEEDED, USE BACK		

If well telescopes please
sketch and show depths.

GROUND LEVEL

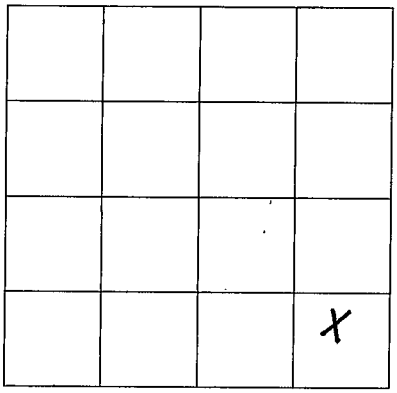

SECTION 10

Please indicate well location X.

ADDITIONAL INFORMATION

If more than one screen,
show location of each on sketch.