WASHINGTON
G 222

MISSISSIPPI DEPARTMENT OF NATURAL RESOURCES

Bureau of Land and Water Resources
Southport Mall
P.O. Box 10631
Jackson, Mississippi 39209

WATER WELL DRILLERS LOG

CODED

6-26-86 19 — date well completed
Schultz Drilling — firm name
WASHINGTON — county well located

LANDOWNER: Mike Kohen
Rt 1 Box 87
Leland, MS
(mailing address)

WELL LOCATION:
sec. 19 T 17 (N) S R. 8 E (W)
5 miles (distance) S (direction) of Greenville (nearest town)

WELL PURPOSE: home
(home, irrigation, municipal, industrial)

WELL COMPLETION DATA:
(1) diameter (inches) 4"X2"
(2) total depth (feet) 490'
(3) static water level (feet) 31' ~~below~~ above top of ground.
(4) casing PVC (material), 470' (depth),
(size) if telescope see back.
(5) screen 20' (length), 470' (depth to top)
2" (size), PVC (material)
(6) pump 1½ (HP) 40 (yield gpm)
ele (type power)
(7) electric log NO (yes or no)
X (organization running log)
(8) how well bottom plugged b/w

DRILLERS REMARKS:

description of formations encountered	from	to
CLAY	0	10
SAND	10	60
SAND + FEW GRAVEL	60	80
CLAY	80	370
MED. SAND	370	400
GOOD SAND	400	490

CODED

RECEIVED
JUL 16 1986
Department of Natural Resources
Bureau of Land & Water Resources

If well telescopes please sketch and show depths.

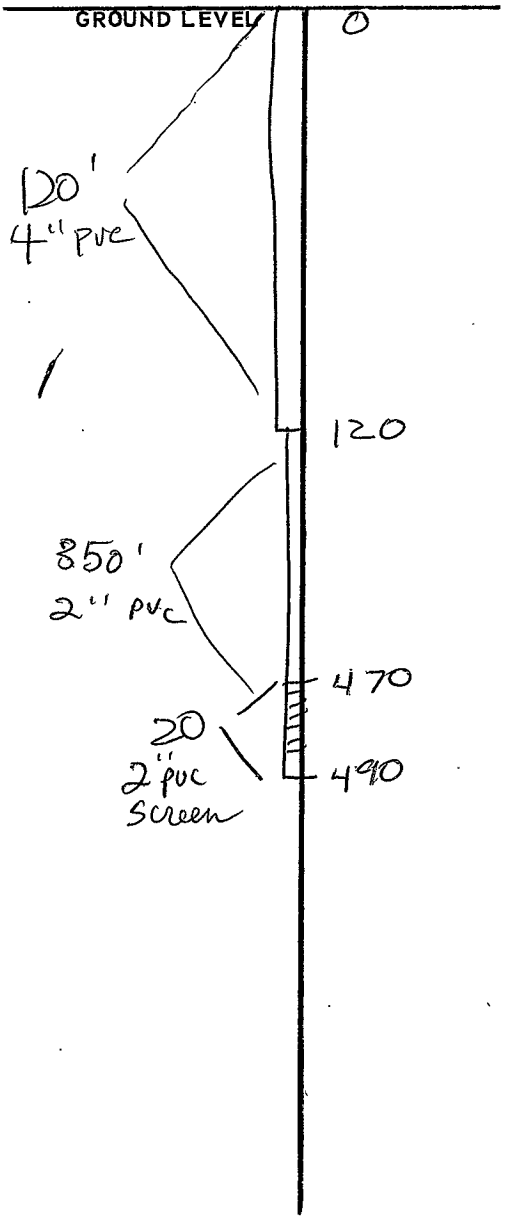

If more than one screen, show locations of each on sketch.

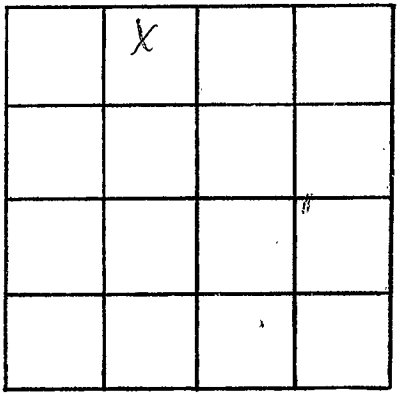

SECTION 19

Please indicate well location X

ADDITIONAL INFORMATION