MISSISSIPPI DEPARTMENT OF NATURAL RESOURCES

Bureau of Land and Water Resources

P.O. Box 10631
Jackson, Mississippi 39209
WATER WELL DRILLERS LOG

COUNTY WELL LOCATED: Wash	
WELL NUMBER: G	CODED:
5077	
DATE WELL COMPLETED: 8-3-88	

PERMIT NUMBER
NAME OF DRILLING FIRM: Schultz Drilling

NAME & MAILING ADDRESS OF LANDOWNER: Wesley McGough

WELL LOCATION: SEC 20 TOWNSHIP 17 (N) S RANGE 9 E (W)

DISTANCE 4 Miles DIRECTION SW of NEAREST TOWN Bvl

OTHER LANDMARK

WELL PURPOSE: (Home) Irrigation, Municipal, Industrial, Fish Pond, etc.

PUMP DATA

PUMP TYPE (Circle One): Submersible, Turbine, (Jet) Flowing Well, Other (Describe)

POWER TYPE (Circle One): (Electric) Tractor, Diesel, Gasoline, Butane, Other (Describe)

Pump Capacity (GPM)	No. of Stages	Setting Depth
10	2	80 FT.

PUMP TEST

Well yielded _____ GPM with

a drawdown of _____ ft.

after _____ hours of pumping

WELL DATA

Well Depth	Casing Diameter (In.)	Casing Length (Ft.)
440	2	430
Type of Casing	**Hole Depth**	**Depth to Static Water Level**
Pvc	450	43'

TYPE OF COMPLETION: (Circle One or More): Gravel Packed, Underreamed, Telescoped, (Natural Development) Open Hole, Other (Describe)

Top of Lap Pipe or Reduction in Casing FEET

IF TELESCOPED OR MORE THAN ONE SCREEN: USE BACK PAGE

LOG DATA

TYPE OF LOG RUN (Circle One): (No Log Run) Electric, Gamma Ray, Density, Sonic, Neutron, Other (Describe)

Name of Organization Running Log

GEOLOGIC DATA (Office Use Only)

Surface Elev.	Geologic Unit	Unit Thickness	Depth to Top
Subs. SWL	Date	Analysis	Aquifer Test

Driller's Remarks

SCREEN DATA

Diameter - Inches	Length - Feet	Slot Size - Inches
2	10	.10
Screen Type		**Depth to Bottom - Feet**
Pvc		

RECEIVED
NOV 29 1988
Department of Natural Resources
Bureau of Land & Water Resources

DESCRIPTION OF FORMATIONS ENCOUNTERED	FROM	TO	FORMATIONS (Continued)	FROM	TO
Clay	0	28			
Sand + Gravel	0	90			
Clay	90	270			
Shale	270	315			
Clay Dense	315	360			
Shale + Clay	360	405			
Sand	405	450			
			IF MORE SPACE IS NEEDED, USE BACK		

If well telescopes please
sketch and show depths.

GROUND LEVEL

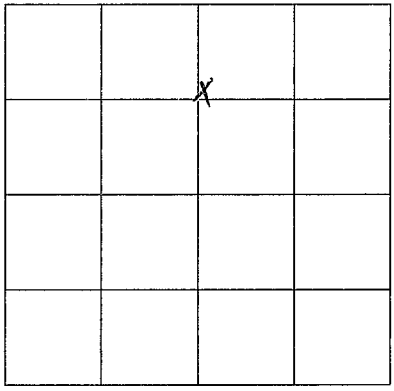

SECTION 20

Please indicate well location X.

ADDITIONAL INFORMATION

If more than one screen,
show location of each on sketch.