MISSISSIPPI DEPARTMENT OF NATURAL RESOURCES

Bureau of Land and Water Resources

P.O. Box 10631
Jackson, Mississippi 39209

WATER WELL DRILLERS LOG

COUNTY WELL LOCATED: Washington	
WELL NUMBER: G	CODED:
2103	
DATE WELL COMPLETED: 10-13-90	

PERMIT NUMBER:
NAME OF DRILLING FIRM: Schultz Drilling

NAME & MAILING ADDRESS OF LANDOWNER
Olivia Spraggins
Rt. 2
Greenville MS 38701

WELL LOCATION: SEC 7 TOWNSHIP 17 (N) S RANGE 9 E (W)

DISTANCE 7 Miles DIRECTION SW of NEAREST TOWN Greenville

OTHER LANDMARK: Greenville, Lake Village Rd.

WELL PURPOSE: Home, Irrigation, Municipal, Industrial, Fish Pond, etc.

PUMP DATA

PUMP TYPE (Circle One): Submersible, Turbine, Jet, Flowing Well, Other (Describe) _____

POWER TYPE (Circle One): Electric, Tractor, Diesel, Gasoline, Butane, Other (Describe) _____

Pump Capacity (GPM)	No. of Stages	Setting Depth
20	6	84 FT.

PUMP TEST

Well yielded _____ GPM with a drawdown of _____ ft. after _____ hours of pumping

WELL DATA

Well Depth	Casing Diameter (In.)	Casing Length (Ft.)
380	4X2	360

Type of Casing	Hole Depth	Depth to Static Water Level
pvc	380	37 ft

TYPE OF COMPLETION: (Circle One or More): Gravel Packed, Underreamed, Telescoped, Natural Development, Open Hole, Other (Describe) _____

Top of Lap Pipe or Reduction in Casing FEET

IF TELESCOPED OR MORE THAN ONE SCREEN: USE BACK PAGE

SCREEN DATA

Diameter - Inches	Length - Feet	Slot Size - Inches
2	20 ft	0.10

Screen Type	Depth to Bottom - Feet
pvc	380

LOG DATA

TYPE OF LOG RUN (Circle One): No Log Run, Electric, Gamma Ray, Density, Sonic, Neutron, Other (Describe) _____

Name of Organization Running Log

GEOLOGIC DATA (Office Use Only)

Surface Elev.	Geologic Unit	Unit Thickness	Depth to Top
Subs. SWL	Date	Analysis	Aquifer Test

Driller's Remarks

RECEIVED
NOV 01 1990
Department of Natural Resources
Bureau of Land & Water Resources

DESCRIPTION OF FORMATIONS ENCOUNTERED	FROM	TO
clay · silt	0	15
sand & gravel	15	120
clay	120	300
sand	300	380

FORMATIONS (Continued)	FROM	TO

IF MORE SPACE IS NEEDED, USE BACK

If well telescopes please
sketch and show depths.

GROUND LEVEL

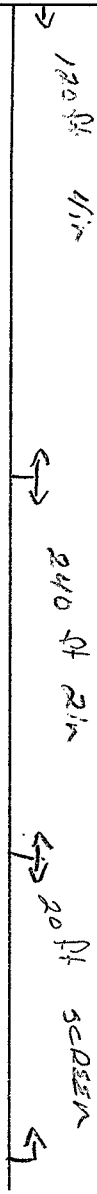

If more than one screen,
show location of each on sketch.

X			

SECTION 7

Please indicate well location X.

ADDITIONAL INFORMATION