Washington
H 83
3-5-80

MISSISSIPPI
BOARD OF WATER COMMISSIONERS
416 North State Street
Jackson, Mississippi 39201

WATER WELL DRILLERS LOG

3/5 1980 — date well completed
Dyer — firm name
Wash. — county well located

LANDOWNER: SANDY INGRAM
ARCOLA, MS
(mailing address)

WELL LOCATION:
sec. 8 T 17 (N) S R 7 E (W)
6 miles (distance) SW (direction) of Leland (nearest town)

WELL PURPOSE:
(home, irrigation, municipal, industrial)

WELL COMPLETION DATA:
(1) diameter (inches) 16"
(2) total depth (feet) 113'
(3) static water level (feet) 22' below above top of ground.
(4) casing Steel (material), 113' (depth), 16" (size) if telescope see back.
(5) screen 40' (length), 73' (depth to top), 16" (size); Steel (material)
(6) pump 80 (HP) 900 (yield gpm)
Diesel (type power)
(7) electric log _____ (yes or no)
_____ (organization running log)
(8) how well bottom plugged plate

DRILLERS REMARKS:

description of formations encountered	from	to
CODED		
Clay	0	28
Fine Sand	28	39
Sand	39	50
Sand + Gravel	50	113
CODED		

MAY 1983 WATER RIGHTS DELINEATION

If well telescopes please sketch and show depths.

GROUND LEVEL

If more than one screen, show locations of each on sketch.

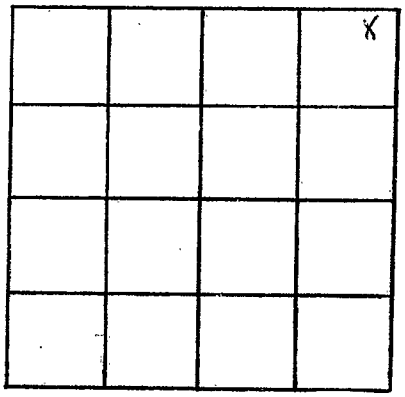

SECTION 8

Please indicate well location X.

ADDITIONAL INFORMATION