Washington
H86
1-18-80

MISSISSIPPI
BOARD OF WATER COMMISSIONERS
416 North State Street
Jackson, Mississippi 39201

WATER WELL DRILLERS LOG

1/15 1980 Dyer Wash.
date well completed — firm name — county well located

LANDOWNER: SANDY INGRAM
Leland, MS.
(mailing address)

WELL LOCATION:
sec. 9 T 20 (N) S R 7 E (W)
5 miles S of Leland
(distance) (direction) (nearest town)

WELL PURPOSE:
(home, irrigation, municipal, industrial)

WELL COMPLETION DATA:
(1) diameter (inches) 16"
(2) total depth (feet) 113'
(3) static water level (feet) 28' below above top of ground.
(4) casing Steel (material), 113' (depth), 16" (size) if telescope see back.
(5) screen 40' (length), 73' (depth to top), 16" (size), Steel (material)
(6) pump 80 (HP) 900 (yield gpm)
Pisell (type power)
(7) electric log _____ (yes or no)
_____ (organization running log)
(8) how well bottom plugged plate

DRILLERS REMARKS:

description of formations encountered CODED	from	to
Clay	0	28
Fine Sand	28	38
Sand	38	45
Sand + Gravel	45	113

CODED

MAY 1981 RECEIVED

If well telescopes please sketch and show depths.

GROUND LEVEL

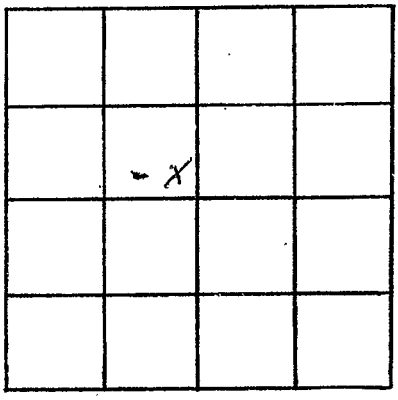

SECTION 9

Please indicate well location X.

ADDITIONAL INFORMATION

If more than one screen, show locations of each on sketch.