

513

7-22-63

WATER WELL DRILLERS LOG

Date: July 22, 1963, Driller: DELTA DRILLING Co. County WASHINGTON

(Name)

WELL #1 CAMERON & JOHN DEAN

(1) Owner of Land: DEAN & Co.

TRIBBETT (Name) HEADQUARTERS

TRIBBETT, MISS. (Address)

(2) Location: SE 1/4, NE 1/4, Sec. 3 T17R6

miles (distance) of Tribbett (direction) (Nearest Town)

(3) Topography: (Hilly) (Flat) (Level)

(4) Purpose of Well: DOMESTIC (Domestic Irrigation, Municipal, Industrial, Other)

Description & Color of Materials Sand, Clay, Red Clay, Shell, etc.	Thick- ness Feet	Depth Feet
GUMBO	10	10
SAND	91	101
GRAVEL	22	123
GUMBO	82	205
SHALE	61	266
GUMBO	81	347
SHALE	22	369
SAND	12	381
SHALE	27	408

Information upon completion of well:

(1) Diameter 4 inches.

(2) Total Depth 408 feet.

(3) Water Level 29 feet below top of ground.

(4) Cased to 398, Size 105'-4" 2 1/2"

(5) Screen: Size 2 1/2", Length 10'

(6) Were any formations sealed against pollution? yes, no.


If YES depth of formation

Why

Drillers Remarks: 100-70 RED JACKET DEEP WELL SUBMERSIBLE PUMP UNIT W/ 1000 GAL BLK STEEL PRESSURE TANK SET IN WELL 28'-2 1/2" TAIL PIPE ON BOTTOM END OF WELL. WATER LEVEL - 29'

Note: data incorrect, screen in shale

Probably - cased to 370' screen to 320' tail pipe to 408'

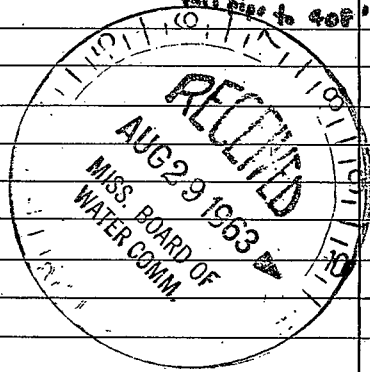

(Use Back Side)

Well No.










