

County: Washington  
 Permit #: GW-45168  
 Irrigation Equipment  
 Driller: \_\_\_\_\_  
 Date drilling completed: 8-4-11

**State Well Report**

**Part 1 - Driller's Log**

Mississippi Department of Environmental Quality  
 Office of Land and Water Resources  
 P.O. Box 2309  
 Jackson, MS 39225  
 (601)961- 5210  
 (601)961- 5228 (fax)

**For Office Use Only:**  
 Aquifer: J107  
 Well #: \_\_\_\_\_  
 L. S. Elevation: \_\_\_\_\_  
 E-log #: \_\_\_\_\_

*State Law requires that this report be prepared by the license holder responsible for the work and filed with the Department at the above address within 30 days of completion of drilling of the well or borehole.*

<p><b>Information on Well Owner</b>          (Landowner if borehole is not for a water well)</p> <p>Owner Name <u>John Mark Looney</u>          Mailing Address: <u>105 Buck Road</u></p> <p><u>Leland</u> <u>Ms.</u> <u>38756</u>          City State Zip Code</p> <p>Telephone No. ( ) _____</p>	<p><b>Well or Borehole Location</b></p> <p>Latitude: <u>33° 20' 35.6"</u> Longitude: <u>90° 47' 38.5"</u></p> <p>Method of Lat/Long (circle one): Conventional Survey, _____          USGS quad, Hand-held GPS, Survey-grade GPS _____</p> <p><u>NW 1/4</u> <u>NE 1/4</u> Sec <u>11</u> <u>NE</u> Twn <u>17N</u> Rng <u>6W</u>          Distance Direction Nearest Town  <u>6</u> Miles <u>SE</u> of <u>Leland</u></p>
--	--

**Well / Borehole Data**

Date drilling started: 8-4-11 Date drilling completed: 8-4-11 Hole depth: 117 Hole diameter: 24"

Location of the source of any surface water used for drilling: Surface Water  
 Method of dosing and volume of Chlorine used in drilling and development: 50 PPM

Logs run (circle all applicable) No log run Electric Gamma Ray Density Sonic Neutron Other: \_\_\_\_\_  
 Name of organization running log(s): \_\_\_\_\_

Purpose of borehole (check one): Water Well  Geotechnical/Geological Investigation \_\_\_\_\_ Ground Source Heat Pump \_\_\_\_\_  
 Seismic Survey \_\_\_\_\_ Other (describe) \_\_\_\_\_

*If drilling is not related to water well construction, skip the remainder of this block*

Purpose of Well (check one): Home \_\_\_\_\_ Industrial \_\_\_\_\_ Public Supply \_\_\_\_\_ Irrigation  Fish Culture \_\_\_\_\_ Other: \_\_\_\_\_

If a flowing well, method of flow regulation: Valve \_\_\_\_\_ Other (describe) \_\_\_\_\_

Static Water Level: \_\_\_\_\_ feet above or below (circle one) land surface Date measured: \_\_\_\_\_

Method of Measurement (circle one) steel tape electric tape air line other: \_\_\_\_\_

Well depth: 117 Well grouted to a depth of 10 feet Type of grout (circle one): Neat Cement Bentonite Mix

Casing length: 77 feet Casing diameter: 16 inches Type of casing: PVC

Screen length: 40 feet Screen diameter: 16 inches Type of screen: PVC

Screen slot size: .050 inches Setting depth: From 78 feet to 117 feet

Type of completion (circle all applicable): Gravel packed Underreamed Telescoped Open hole Natural Development  
 Other (describe): \_\_\_\_\_

Top of lap pipe or reduction in casing: \_\_\_\_\_ feet. *If telescoped or more than one screen, describe on next page*

Form: OLWR-SWR-1A (04/08)


RECEIVED  
 AUG 22 2011  
 BY: OLWR

5107

The sketch below only required for water wells

If well telescopes, show depths on sketch.

Ground Level →

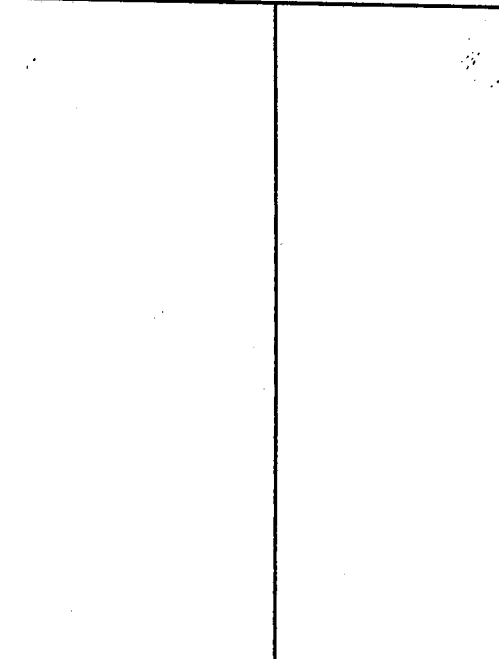

Description of formations encountered must be provided for all wells and boreholes, unless specifically exempted by regulations

Description of Formations Encountered	From (depth)	To (depth)
Clay	Ground Level	21
Fine Sand	22	37
Fine Sand + Gravel	28	35
Medium Sand + Gravel	56	117

If more than one screen, show location of each on sketch

Sketch the property layout and include the following: 1) the well location; 2) any permanent structures on the property that may aid in locating the well; 3) any roads, power lines, or other items that may aid in locating the property and the well; 4) a north arrow.


Landowner Name: John Mark Looney

Form: OLWR-SWR-1A (04/08)

I certify that the well/borehole was drilled, constructed, and completed in accordance with all applicable requirements of the Mississippi Department of Environmental Quality and the Mississippi Department of Health regulations, if applicable, and state laws.

Patrick M. Chism 0695

Print Name of Responsible Licensee and License No. \_\_\_\_\_ Date \_\_\_\_\_ Signature of Licensee \_\_\_\_\_

 

County: Washington  
Permit #: GW-45168  
Irrigation Equipment  
Driller: \_\_\_\_\_  
Date completed: 8-4-11  
*Copy information from block on Part 1*

# STATE WELL REPORT

## Part 2

Pump Installer's Completion Report  
Mississippi Department of Environmental Quality  
Office of Land and Water Resources  
P.O. Box 2309  
Jackson, MS 39225  
(601)961-5210  
(601)961-5228 (fax)

For Office Use Only:  
Aquifer: \_\_\_\_\_  
Well #: J107  
Elevation: \_\_\_\_\_

This part of the report must be completed by a licensed water well contractor or a licensed pump installer. A copy of Part 1 of the report must be attached and both parts filed with the Department at the above address within 30 days of well completion.

Well Owner Information	Well Location
Owner Name: <u>John Mark Looney</u> Mailing Address: <u>105 Buck Road</u> <u>Leland Ms. 38756</u> City State Zip Code Telephone No. ( ) _____	Latitude: _____ Longitude: _____ Method of Lat/Long (check one): Conventional Survey _____ USGS quad _____, Hand-held GPS _____, Survey-grade GPS _____ <u>NW</u> $\frac{1}{4}$ <u>NE</u> $\frac{1}{4}$ Sec <u>11</u> T. <u>17N</u> R. <u>6W</u> Distance Direction Nearest Town <u>6</u> Miles <u>SE</u> of <u>Leland</u>

Pump Type	Power Type
Air Lift Bucket Centrifugal Other (specify): _____ Date Pump Installed: <u>8-8-11</u> Rated Pump Capacity: <u>2500</u> ± Gallons Per Minute	<input checked="" type="radio"/> Diesel Engine <input type="radio"/> Gasoline Engine <input type="radio"/> Natural Gas Electric Motor Windmill Other (specify): _____ Horse Power Rating of Motor: <u>60</u> Setting Depth: <u>70</u> feet Number of Stages: <u>1</u>
Circle one Jet Submersible Piston <u>Turbine</u> Rotary Flowing Well	Circle one Hand Tractor PTO

Pump Test Data	Method of Measuring Water Level
Date Well Tested: _____ Static Water Level (A): _____ Feet Below Land Surface Pumping Water Level (B): _____ Feet Below Land Surface Drawdown [(B) - (A)]: _____ Feet Below Land Surface Test Pumping Rate: _____ Gallons Per Minute Duration of Pump Test (minimum 4 hours): _____ hours	Circle one Air Line Electric Measuring Line Steel Tape Other (specify): _____ For flowing well, measured shut in head: _____ feet Well yielded _____ GPM with a drawdown of _____ feet after _____ hours of pumping

This is for (circle one):    New Well    Replacement of Existing Pump    Repair of Existing Pump

I HEREBY CERTIFY that the above statements are true to the best of my knowledge.  
Patrick M. Chism    0695  
Print Name of Pump Installer and License No. (if applicable)    Signature of Pump Installer