MISSISSIPPI DEPARTMENT OF ENVIRONMENTAL QUALITY
Bureau of Land and Water Resources

P. O. Box 10631
Jackson, MS 39289-0631
WATER WELL DRILLERS LOG

COUNTY WELL LOCATED: Washington	
WELL NUMBER: J	CODED:
2013	
DATE WELL COMPLETED: 7-1-91	

146D

PERMIT NUMBER: 4	
NAME OF DRILLING FIRM: Schultz Drilling	

NAME & MAILING ADDRESS OF LANDOWNER
Ross Pltn.
Box 349
Arcola Ms.

WELL LOCATION: SEC 36 TOWNSHIP 17 (N) S RANGE 6 E (W)

DISTANCE 6 Miles DIRECTION East of NEAREST TOWN Arcola

OTHER LANDMARK

WELL PURPOSE: Home, (Irrigation), Municipal, Industrial, Fish Pond, etc.

PUMP DATA

PUMP TYPE (Circle One): Submersible, (Turbine), Jet, Flowing Well, Other (Describe) Owners

POWER TYPE (Circle One): Electric, (Tractor), Diesel, Gasoline, Butane, Other (Describe) _____ H/P _____

Pump Capacity (GPM)	No. of Stages	Setting Depth
3000		FT.

PUMP TEST

Well yielded _____ GPM with a drawdown of _____ ft. after _____ hours of pumping

WELL DATA

Well Depth	Casing Diameter (In.)	Casing Length (Ft.)
100	16	60

Type of Casing	Hole Depth	Depth to Static Water Level
steel	100	29

TYPE OF COMPLETION: (Circle One or More): (Gravel Packed), Underreamed, Telescoped, Natural Development, Open Hole, Other (Describe) Hole plug

Top of Lap Pipe or Reduction in Casing FEET

IF TELESCOPED OR MORE THAN ONE SCREEN: USE BACK PAGE

LOG DATA

TYPE OF LOG RUN (Circle One): (No Log Run), Electric, Gamma Ray, Density, Sonic, Neutron, Other (Describe) _____

Name of Organization Running Log

GEOLOGIC DATA (Office Use Only)

Surface Elev.	Geologic Unit	Unit Thickness	Depth to Top
Subs. SWL	Date	Analysis	Aquifer Test

Driller's Remarks

SCREEN DATA

Diameter - Inches	Length - Feet	Slot Size - Inches
16	40	.050

Screen Type	Depth to Bottom - Feet
steel	100

DESCRIPTION OF FORMATIONS ENCOUNTERED	FROM	TO
Clay	0	15
sand	15	45
med sand	45	60
Good Sand & p-gravel	60	100

FORMATIONS (Continued) FROM TO

IF MORE SPACE IS NEEDED, USE BACK

RECEIVED
DEC 06 1991
Dept. of Environmental Quality
Bureau of Land & Water Resources

If well telescopes please
sketch and show depths.

GROUND LEVEL

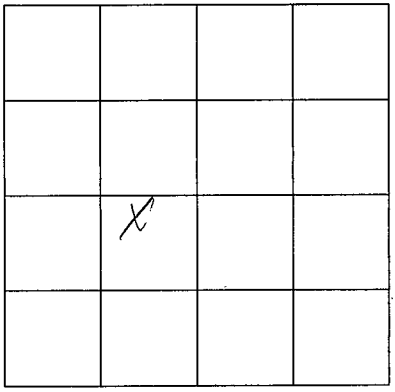

SECTION 36

Please indicate well location X.

ADDITIONAL INFORMATION

If more than one screen,
show location of each on sketch.