

WASH.

MISSISSIPPI BOARD OF WATER COMMISSIONERS

K19

5-14-62

WATER WELL DRILLERS LOG

Date: 5/14, 1962, Driller: Bailey Drlg Co, County: Washington

| (1) Owner of Land | Description & Color of Materials Sand, Clay, Red Clay, Shell, etc. | Thick- ness Feet | Depth Feet |
|--|---|------------------------|---------------|
| Riverside School (Name) Aron, Miss. (Address) | Clay Sand | 20 57 | 20 71 |
| (2) Location: 1/4, 1/4, Sec. 5 T. R. | | | |
| _____ miles _____ of _____ (distance) (direction) (Nearest Town) | | | |
| (3) Topography: Flat (Hilly) (Flat) (Level) | | | |
| (4) Purpose of Well: Irrigation (Domestic Irrigation Municipal, Industrial, Other) | | | |


Information upon completion of well:

- (1) Diameter 2 x 1 1/4 inches.
- (2) Total Depth 71 feet.
- (3) Water Level 7 feet below top of ground.
- (4) Cased to all way Size 2 x 1 1/4
- (5) Screen: Size 1 1/4, Length 5 ft.
- (6) Were any formations sealed against pollution?
_____ yes, no.

If YES depth of formation _____

Why _____

Drillers Remarks: _____

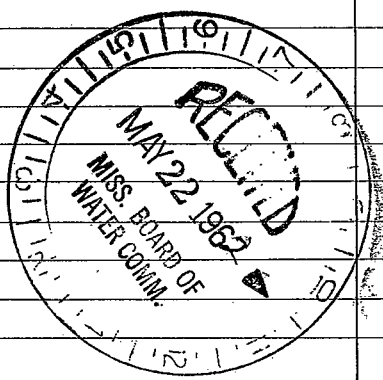

(Use Back Side)

Well No.




