MISSISSIPPI DEPARTMENT OF NATURAL RESOURCES

Bureau of Land and Water Resources

P.O. Box 10631
Jackson, Mississippi 39209
WATER WELL DRILLERS LOG

COUNTY WELL LOCATED: Wash	
WELL NUMBER: R85	CODED: ✓
PERMIT NUMBER	
NAME OF DRILLING FIRM: Schutter Drilling	
DATE WELL COMPLETED: 2-5-88	

NAME & MAILING ADDRESS OF LANDOWNER
Bratton Farms
Rt. 2
Hollandale MS

WELL LOCATION: SEC 32 TOWNSHIP 16 (N) S RANGE 8 (E) W

DISTANCE 13 Miles DIRECTION S of NEAREST TOWN Arl

OTHER LANDMARK

WELL PURPOSE: Home, (Irrigation), Municipal, Industrial, Fish Pond, etc.

PUMP DATA

PUMP TYPE (Circle One): Submersible, (Turbine), Jet, Flowing Well, Other (Describe) _____

POWER TYPE (Circle One): (Electric), Tractor, Diesel, Gasoline, Butane, Other (Describe) _____

Pump Capacity (GPM)	No. of Stages	Setting Depth
2,000	1	60 FT.

PUMP TEST

Well yielded _____ GPM with a drawdown of _____ ft. after _____ hours of pumping

WELL DATA

Well Depth	Casing Diameter (In.)	Casing Length (Ft.)
100	16	60

Type of Casing	Hole Depth	Depth to Static Water Level
PVC	100	27

TYPE OF COMPLETION: (Circle One or More): (Gravel Packed), Underreamed, Telescoped, Natural Development, Open Hole, Other (Describe) _____

Top of Lap Pipe or Reduction in Casing FEET

IF TELESCOPED OR MORE THAN ONE SCREEN: USE BACK PAGE

LOG DATA

TYPE OF LOG RUN (Circle One): (No Log Run), Electric, Gamma Ray, Density, Sonic, Neutron, Other (Describe) _____

Name of Organization Running Log

GEOLOGIC DATA (Office Use Only)

Surface Elev.	Geologic Unit	Unit Thickness	Depth to Top
Subs. SWL	Date	Analysis	Aquifer Test

Driller's Remarks

RECEIVED

SCREEN DATA

Diameter - Inches	Length - Feet	Slot Size - Inches
16	40	.050

Screen Type	Depth to Bottom - Feet
PVC	100

DESCRIPTION OF FORMATIONS ENCOUNTERED	FROM	TO
Clay	0	40
Sand & Gravel	40	100

FORMATIONS (Continued)	FROM	TO

RECEIVED NOV 29 1988 Department of Natural Resources Bureau of Land & Water Resources

IF MORE SPACE IS NEEDED, USE BACK

If well telescopes please
sketch and show depths.

GROUND LEVEL

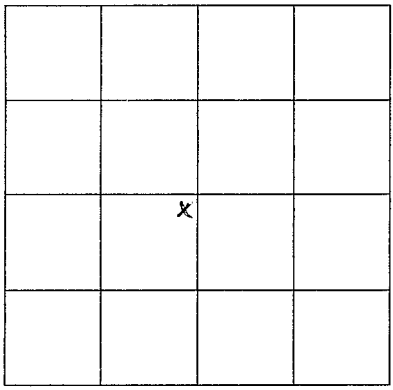

SECTION 32

Please indicate well location X.

ADDITIONAL INFORMATION

If more than one screen,
show location of each on sketch.