

WASH. MISSISSIPPI BOARD OF WATER COMMISSIONERS

~~10-1-62~~ L43

CODED K

WATER WELL DRILLERS LOG

Date: 10/1, 1962, Driller: Palmyra Co. County: Washington
(Name)

(1) Owner of Land: Moise Cox
(Name)
Hollandale, Miss.
(Address)
27 1/2 N W

(2) Location: 1/4, 1/4, Sec. 27 T. R
3 miles East of Avon
(distance) (direction) (Nearest Town)

(3) Topography: Flat
(Hilly) (Flat) (Level)

(4) Purpose of Well: Domestic
(Domestic Irrigation
Municipal, Industrial, Other)

Description & Color of Materials Sand, Clay, Red Clay, Shell, etc.	Thick- ness Feet	Depth Feet
<u>Clay</u>		<u>40</u>
<u>Sand</u>		<u>71</u>
<u>Gravel</u>		<u>120</u>
<u>Mud</u>		<u>250</u>
<u>Fine Sand</u>		<u>350</u>
<u>Medium CI</u>		<u>377</u>

CODED

Information upon completion of well:

(1) Diameter 2 1/2 X 2 inches.

(2) Total Depth 377 feet.

(3) Water Level 15 feet below top of ground.

(4) Cased to all way, Size 2 1/2 X 2.

(5) Screen: Size 2, Length 10ft.


(6) Were any formations sealed against pollution?
_____ yes, X no.

Insert info to locate

If YES depth of formation _____

Why _____

Drillers Remarks: _____

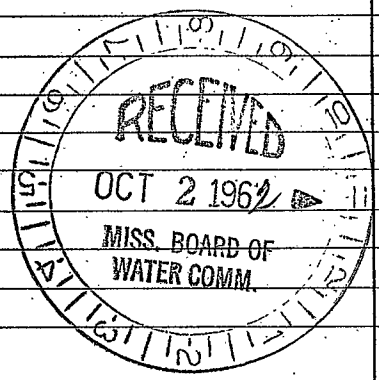

(Use Back Side)

Well No.











