WASHINGTON
L 75
9/13/79

Received
DNR
9/24/79

MISSISSIPPI
BOARD OF WATER COMMISSIONERS
416 North State Street
Jackson, Mississippi 39201

CODED

WATER WELL DRILLERS LOG

9-13 1979 Dyer Well + Irrigation Washington
date well completed — firm name — county well located

LANDOWNER: RANDY WINGFIELD
ARCOLA, MISS
(mailing address)

WELL LOCATION:
sec. 3 T 16 (N) S R 7 E (W)
1½ (distance) miles W (direction) of Arcola (nearest town)

WELL PURPOSE: IRRIGATION
(home, irrigation, municipal, industrial)

WELL COMPLETION DATA:
(1) diameter (inches) 16"
(2) total depth (feet) 113'
(3) static water level (feet) 21' below above top of ground. 73'
(4) casing Steel (material), ~~113'~~ (depth),
16" (size) if telescope see back.
(5) screen 40' (length), 73' (depth to top)
16" (size), Steel (material)
(6) pump 50 (HP) 1,100 (yield gpm)
Electric (type power)
(7) electric log No (yes or no)
(organization running log)
(8) how well bottom plugged Plate

DRILLERS REMARKS:

description of formations encountered	from	to
Clay	0	28
Fine Sand	28	34
Sand	34	48
Sand + Gravel	48	113

CODED

If well telescopes please sketch and show depths.

GROUND LEVEL

If more than one screen, show locations of each on sketch.

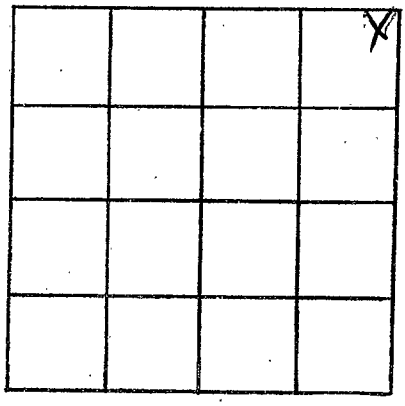

SECTION 3

Please indicate well location X.

ADDITIONAL INFORMATION