Washington
L 77
3-6-80

MISSISSIPPI
BOARD OF WATER COMMISSIONERS
416 North State Street
Jackson, Mississippi 39201

WATER WELL DRILLERS LOG

3/6 1980 — date well completed
Dyer — firm name
Washington — county well located

LANDOWNER: JACK NEWTON
HOLLANDALE, MS.
(mailing address)

WELL LOCATION: NE NE
sec. 36 T 16 (N) S R 7 E (W)
2 miles N of Hollandale
(distance) (direction) (nearest town)

WELL PURPOSE: Irrigation
(home, irrigation, municipal, industrial)

WELL COMPLETION DATA:

(1) diameter (inches) 16"
(2) total depth (feet) 111'
(3) static water level (feet) 20' below above top of ground.
(4) casing 16" (material), 111' (depth),
16" (size) if telescope see back.
(5) screen 40' (length), 71' (depth to top)
16" (size), Steel (material)
(6) pump 60 (HP) 3000 (yield gpm)
Diesel (type power)
(7) electric log _____ (yes or no)
_____ (organization running log)
(8) how well bottom plugged plate

DRILLERS REMARKS:

description of formation encountered	from	to
GODED		
Clay	0	28
Fine Sand	28	38
Sand	38	48
Sand + Gravel	48	111
CODED		

MAY 1981 RECEIVED

If well telescopes please sketch and show depths.

GROUND LEVEL

If more than one screen, show locations of each on sketch.

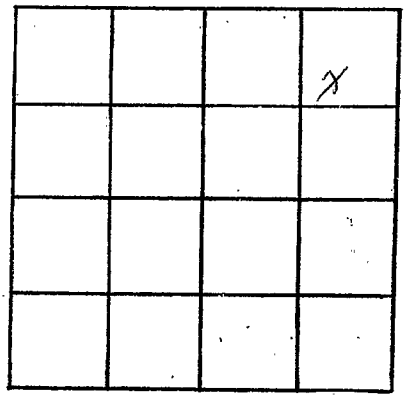

SECTION 36

Please indicate well location X.

ADDITIONAL INFORMATION