Washington
L 2000

MISSISSIPPI DEPARTMENT OF NATURAL RESOURCES

Bureau of Land and Water Resources
Southport Mall
P.O. Box 10631
Jackson, Mississippi 39209

WATER WELL DRILLERS LOG

5-1 1982 Schultz Drilling Washington
date well completed — firm name — county well located

LANDOWNER: Judge Scates Jr.
Avon MS
(mailing address)

WELL LOCATION:
sec. 8 T 16 (N) S R 7 E (W)
3 (distance) miles E (direction) of Wayside (nearest town)

WELL PURPOSE: Home
(home, irrigation, municipal, industrial)

WELL COMPLETION DATA:

(1) diameter (inches) 4"X2"

(2) total depth (feet) 460'

(3) static water level (feet) 30' below above top of ground.

(4) casing PVC (material), 440' (depth),
_____ (size) if telescope see back.

(5) screen 20' (length), 440' (depth to top)
2" (size), PVC Wrapped (material)

(6) pump 1 (HP) 19 (yield gpm)
E/E (type power)

(7) electric log NO (yes or no)
_____ (organization running log)

(8) how well bottom plugged b/w

DRILLERS REMARKS:

description of formations encountered	from	to
Clay	0	20
SAND + pea gravel	20	75
Gravel + SAND	75	120
Clay	120	123
Coarse SAND + gravel	123	180
SANDY CLAY	180	390
SAND	390	460

DEPT. OF NATURAL RESOURCES
BUREAU OF LAND & WATER RESOURCES
MAY 14 1982
RECEIVED

If well telescopes please sketch and show depths.

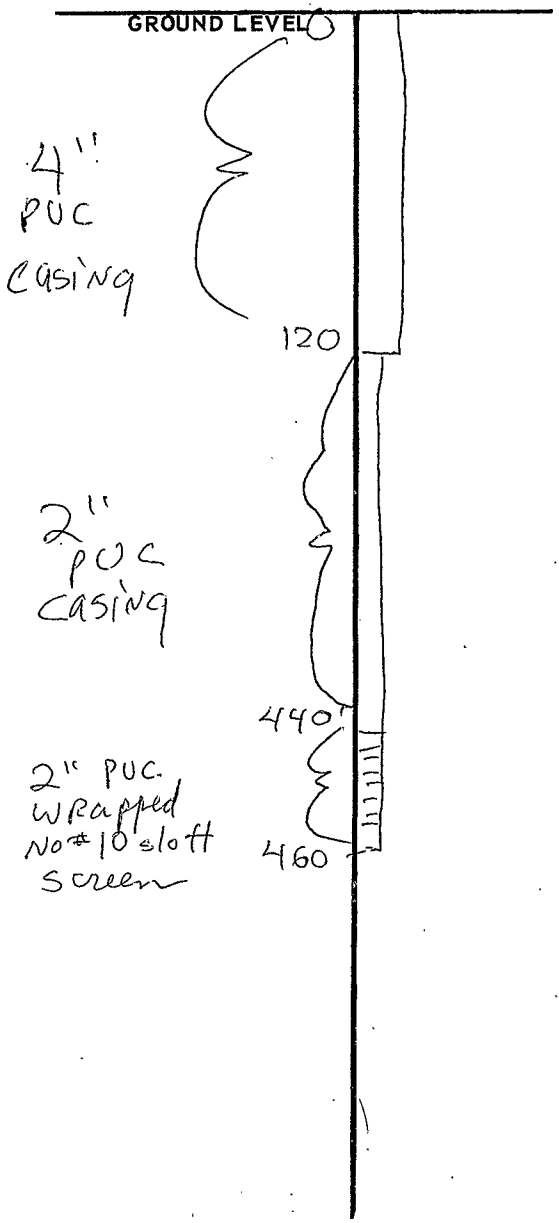

If more than one screen, show locations of each on sketch.

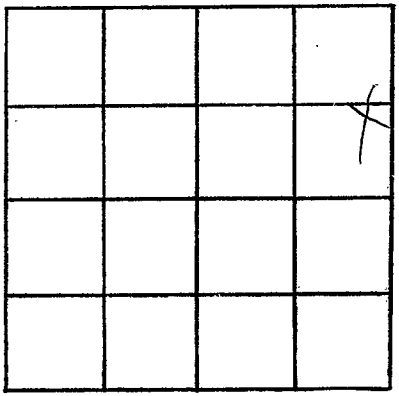

SECTION _____

Please indicate well location X.

ADDITIONAL INFORMATION