

WASH.

MISSISSIPPI BOARD OF WATER COMMISSIONERS

M27

5-18-64

WATER WELL DRILLERS LOG

Date: MAY 18, 1964, Driller: DELTA DRILLING Co. County WASHINGTON

(Name)

(1) Owner of Land: FRANK MESHAN (Name)

DARLOVE, MISS (Address)

(2) Location: SE 1/4, NE 1/4, Sec. 19 T4N R5W

miles of (distance) (direction) (Nearest Town)

(3) Topography: (Hilly) (Flat) (Level)

(4) Purpose of Well: DOMESTIC (Domestic Irrigation Municipal, Industrial, Other)

Description & Color of Materials Sand, Clay, Red Clay, Shell, etc.	Thick- ness Feet	Depth Feet
GUMBO	16	16
SAND	89	105
GRAVEL	32	137
GUMBO	80	217
SHALE W/5" ROCK	43	260
GUMBO	25	285
SHALE	20	305
FINE SAND	34	339
SHALE	40	379
GUMBO	30	409
SHALE	45	454
SAND	45	489
SHALE SAND ?	14	513

Information upon completion of well:

(1) Diameter 4 inches.

(2) Total Depth 513 feet.

(3) Water Level feet below top of ground.

(4) Cased to 513, Size 4" 113', 3" 63', 2" 337'

(5) Screen: Size 2", Length 10'

(6) Were any formations sealed against pollution?

yes, no.


If YES depth of formation

Why

Drillers Remarks: 3/4 H.P. RED JACKET

DEEP WELL, SUBMERSIBLE PUMP SET IN WELL - 10' GAP OF 2" IN 3" PIPE

Screen in shale!

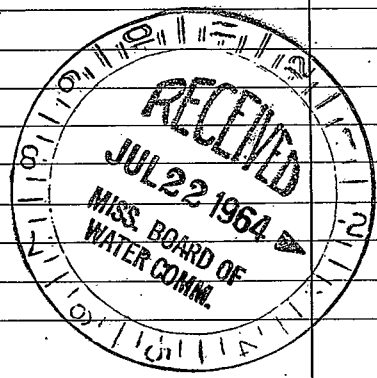

(Use Back Side)

Well No.





