Washington
M-81
10-27-79

MISSISSIPPI
BOARD OF WATER COMMISSIONERS
416 North State Street
Jackson, Mississippi 39201

WATER WELL DRILLERS LOG

10/27 1979 — date well completed
Dyer — firm name
Wash. — county well located

LANDOWNER:
TRAIL LAKE
ARCOLA, MS.
(mailing address)

WELL LOCATION:
sec. 2 T 16 (N) S R 6 E (W)
5 miles E of Arcola
(distance) (direction) (nearest town)

WELL PURPOSE:
(home, irrigation, municipal, industrial)

WELL COMPLETION DATA:

(1) diameter (inches) 12
(2) total depth (feet) 103'
(3) static water level (feet) 22' below above top of ground.
(4) casing Steel (material), 103' (depth), 12" (size) if telescope see back.
(5) screen 40' (length), 63' (depth to top), 12" (size), Steel (material)
(6) pump 30 (HP) 1000 (yield gpm)
ELECTRIC (type power)
(7) electric log _____ (yes or no)
_____ (organization running log)
(8) how well bottom plugged plate

DRILLERS REMARKS:

CODED

description of formations encountered	from	to
Clay	0	28
Fine sand	28	35
Sand	35	48
Sand + Gravel	48	103

CODED

MAY 1981 RECEIVED

If well telescopes please sketch and show depths.

GROUND LEVEL

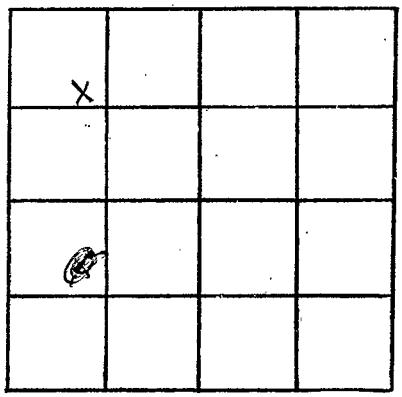

SECTION 2

Please indicate well location X.

ADDITIONAL INFORMATION

If more than one screen, show locations of each on sketch.