

WASH.

## MISSISSIPPI BOARD OF WATER COMMISSIONERS

CODED

## WATER WELL DRILLERS LOG

Date: 5/23, 1964, Driller: Bailey & Co. County: Washington

(1) Owner of Land: J. E. Bratton

(Name)

Description & Color of Materials  
Sand, Clay, Red Clay, Shell, etc.Thick-  
ness  
FeetDepth  
FeetHollandale, Miss.

(Address)

(2) Location: 1/4, 1/4, Sec. 31 T. 8 N. R. 1 W.5 miles  
(distance)

(direction)

(Nearest Town)

(3) Topography: Flat

(Hilly)

(Flat)

(Level)

(4) Purpose of Well: Domestic(Domestic Irrigation  
Municipal, Industrial, Other)

Mud	60
Sand	160
Gravel	190
Mud	340
Sand	370
Mud	400
Sand	460
Mud	600
Sand	646

## Information upon completion of well:

(1) Diameter 4X2 inches.(2) Total Depth 646 feet.(3) Water Level 21 feet below top of ground.(4) Cased to all way, Size 4X2(5) Screen: Size 2, Length 10 ft.

(6) Were any formations sealed against pollution?

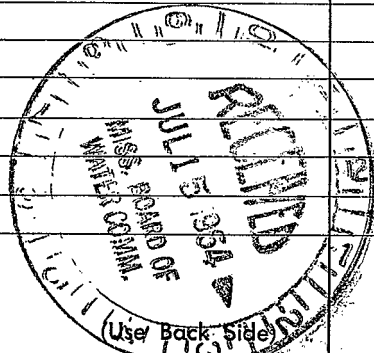
yes, X no.

If YES depth of formation \_\_\_\_\_

Why \_\_\_\_\_

Drillers' Remarks: \_\_\_\_\_

CODED

Insuff. inf.  
to locate

Well No.

Mail this copy to Board of Water Commissioners 429 Miss. St. Jackson, Miss.










