WASH.
N53
12-3-73

MISSISSIPPI
BOARD OF WATER COMMISSIONERS
416 North State Street
Jackson, Mississippi 39201

WATER WELL DRILLERS LOG

12/3 date well completed 1973 Bailey Drilling Co. firm name Washington county well located

LANDOWNER: J.J. Pogue
Avon, Miss
(mailing address)

WELL LOCATION:
sec. 2 T 15 N/S R 8 E/W
5 (distance) miles SE (direction) of Avon (nearest town)

WELL PURPOSE: Home
(home, irrigation, municipal, industrial)

WELL COMPLETION DATA:

(1) diameter (inches) 4X2½X2
(2) total depth (feet) 945
(3) static water level (feet) 26 below ~~above~~ top of ground.
(4) casing Steel (material), 930 (depth),
4X2½X2 (size) if telescope see back.
(5) screen 15' (length), 930 (depth to top)
2" (size), Stainless Steel (material)
(6) pump ¾ (HP) 15 (yield gpm)
Electric (type power)
(7) electric log No (yes or no)
(organization running log)
(8) how well bottom plugged Back pressure valve

DRILLERS REMARKS:

description of formations encountered	from	to
Clay	0	30
Sand	30	75
Gravel	75	130
Mud	130	440
Sand	440	490
Mud	490	740
Mud + Sand	740	800
Mud	800	880
Sand	880	945

CODED

MISS. BD. OF WATER COMM.

If well telescopes please sketch and show depths.

GROUND LEVEL

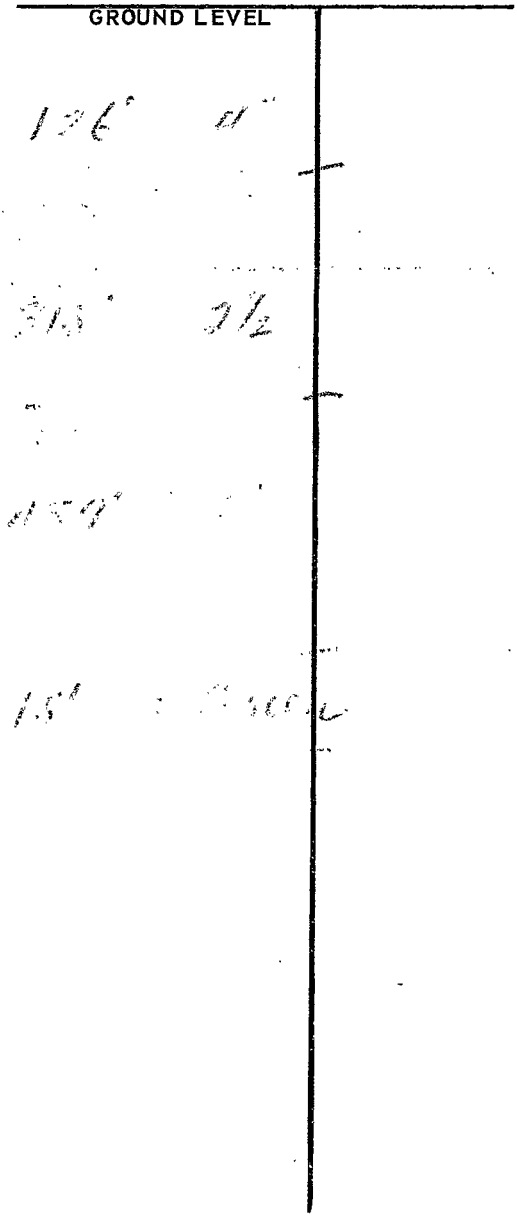

If more than one screen, show locations of each on sketch.

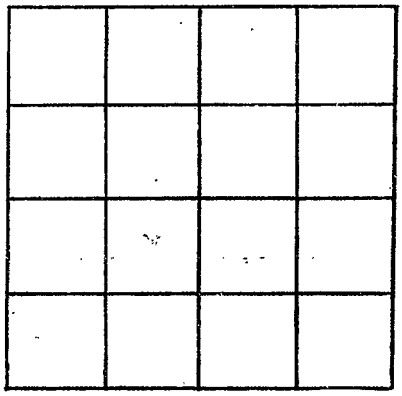

SECTION _____

Please indicate well location X.

ADDITIONAL INFORMATION