WASHINGTON
N 80
7-20-81

MISSISSIPPI DEPARTMENT OF NATURAL RESOURCES

Bureau of Land and Water Resources
Southport Mall
P.O. Box 10631
Jackson, Mississippi 39209

CODED

WATER WELL DRILLERS LOG

July 20 19 81 — date well completed
Bruce Berryman — firm name
WASHINGTON — county well located

LANDOWNER: Mount Holly Pltn
P.O. Box 853
Greenville. MS 38701
(mailing address)

WELL LOCATION:
sec. 2 T 15 N R 8 W
3 miles S of Glen Allan
(distance) (direction) (nearest town)

WELL PURPOSE: Home
(home, irrigation, municipal, industrial)

WELL COMPLETION DATA:

(1) diameter (inches) 4" x 2"
(2) total depth (feet) 860'
(3) static water level (feet) 30 below ~~above~~ top of ground.
(4) casing 4" blk. - 126' / 2" Galv. - 714'
(material) (depth)
_____ (size) If telescope see back.
(5) screen 20' (length), 840' (depth to top)
2" .010 (size), Stainless steel (material)
(6) pump 1 (HP) 30 (yield gpm)
Electric (type power)
(7) electric log No (yes or no)
_____ (organization running log)
(8) how well bottom plugged B.P.V.

DRILLERS REMARKS:

description of formations encountered	from	to
Clay	0	20
Sand	20	60
Sand & Gravel	60	100
Clay	100	160
Sand	160	280
Shale & Str. sand	280	400
Shale	400	450
Sand	450	460
Shale	460	500
Sand & rock	500	510
Shale	510	550
Sand	550	560
Sandy shale	560	630
Sand	630	650
Shale	650	730
Fine sand	730	780
Sand	780	810
Shale	810	830
Sand	830	860

CODED

DEPT. OF NATURAL RESOURCES
BUREAU OF LAND & WATER RESOURCES
NOV 18 1981
RECEIVED

If well telescopes please sketch and show depths.

GROUND LEVEL

If more than one screen, show locations of each on sketch.

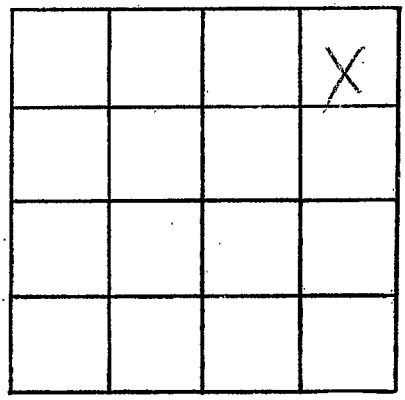

SECTION 2

Please indicate well location X.

ADDITIONAL INFORMATION