MISSISSIPPI DEPARTMENT OF NATURAL RESOURCES

Bureau of Land and Water Resources

P.O. Box 10631
Jackson, Mississippi 39209

WATER WELL DRILLERS LOG

CODED

COUNTY WELL LOCATED	Washington
WELL NUMBER	N105
CODED	
DATE WELL COMPLETED	June 30, 1988
PERMIT NUMBER	
NAME OF DRILLING FIRM	Larry's Well + Pump

NAME & MAILING ADDRESS OF LANDOWNER: E. G. Nelson, Inc.

Chatham, MS.

WELL LOCATION: SEC 19 TOWNSHIP 15 (N) S RANGE 8 (E) W

NW¼SE¼

DISTANCE 4 Miles DIRECTION NE of ~~Chatham~~ Chatahaam

OTHER LANDMARK

WELL PURPOSE: Home, (Irrigation), Municipal, Industrial, Fish Pond, etc.

PUMP DATA

PUMP TYPE (Circle One): Submersible, (Turbine), Jet, Flowing Well, Other (Describe)

POWER TYPE (Circle One): Electric, (Tractor), Diesel, Gasoline, Butane, Other (Describe)

Pump Capacity (GPM)	No. of Stages	Setting Depth
1500	3	50 FT.

PUMP TEST

Well yielded _____ GPM with a drawdown of _____ ft. after _____ hours of pumping

WELL DATA

Well Depth	Casing Diameter (In.)	Casing Length (Ft.)
106'	12"	66'

Type of Casing	Hole Depth	Depth to Static Water Level
Steel	106	20'

TYPE OF COMPLETION: (Circle One or More): (Gravel Packed), Underreamed, Telescoped, Natural Development, Open Hole, Other (Describe)

Top of Lap Pipe or Reduction in Casing FEET

IF TELESCOPED OR MORE THAN ONE SCREEN: USE BACK PAGE

LOG DATA

TYPE OF LOG RUN (Circle One): (No Log Run), Electric, Gamma Ray, Density, Sonic, Neutron, Other (Describe)

Name of Organization Running Log

GEOLOGIC DATA (Office Use Only)

Surface Elev.	Geologic Unit	Unit Thickness	Depth to Top
Subs. SWL	Date	Analysis	Aquifer Test

Driller's Remarks

SCREEN DATA

Diameter - Inches	Length - Feet	Slot Size - Inches
12	40	1060

Screen Type	Depth to Bottom - Feet
steel	106'

DESCRIPTION OF FORMATIONS ENCOUNTERED	FROM	TO
Clay	0	47
Fine Sand	47	66
Coarse sand + gravel	66	106

FORMATIONS (Continued)	FROM	TO

RECEIVED
NOV 18 1988
Department of Natural Resources
Bureau of Land & Water Resources

IF MORE SPACE IS NEEDED, USE BACK

If well telescopes please
sketch and show depths.

GROUND LEVEL

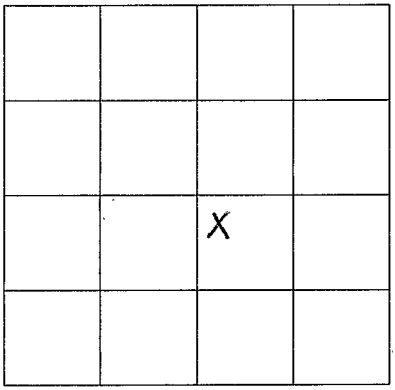

SECTION 19

Please indicate well location X.

ADDITIONAL INFORMATION

If more than one screen,
show location of each on sketch.