MISSISSIPPI DEPARTMENT OF ENVIRONMENTAL QUALITY
Office of Land and Water Resources

P. O. Box 10631
Jackson, MS 39289-0631
WATER WELL DRILLERS LOG

COUNTY WELL LOCATED	Washington
WELL NUMBER	P-79
CODED	
PERMIT NUMBER	
NAME OF DRILLING FIRM	Layne-Central, a div. of Layne Christensen Co.
DATE WELL COMPLETED	5/12/00

NAME & MAILING ADDRESS OF LANDOWNER
Fontenot & Fontenot Rice Farms
203 Oak Court Drive
Hollandale, MS 38748

WELL LOCATION	SEC	TOWNSHIP	RANGE
	12	15 N	7 W

DISTANCE	DIRECTION	NEAREST TOWN
2 Miles	West of	Hollandale

OTHER LANDMARK

WELL PURPOSE: Home, (Irrigation), Municipal, Industrial, Fish Pond, etc.
Irrigation

PUMP DATA

PUMP TYPE (Circle One): Submersible, (Turbine), Jet, Flowing Well, Other (Describe) _____

POWER TYPE (Circle One): Electric, Tractor, (Diesel), Gasoline, Butane, Other (Describe) _____ H/P _____

Pump Capacity (GPM)	No. of Stages	Setting Depth
1500	1	60 FT.

PUMP TEST
Well yielded Not Tested GPM with a drawdown of _____ ft. after _____ hours of pumping

WELL DATA

Well Depth	Casing Diameter (In.)	Casing Length (Ft.)
118'	16"	78'

Type of Casing	Hole Depth	Depth to Static Water Level
PVC	118'	29'

TYPE OF COMPLETION: (Circle One or More): (Gravel Packed), Underreamed, Telescoped, Natural Development, Open Hole, Other (Describe) _____

WELL GROUTED TO A DEPTH OF 10 FEET
Type Grout (circle one): (Cement), Bentonite, or Mix

LOG DATA

TYPE OF LOG RUN (Circle One): (No Log Run), Electric, Gamma Ray, Density, Sonic, Neutron, Other (Describe) _____

Name of Organization Running Log

GEOLOGIC DATA (Office Use Only)

Surface Elev.	Geologic Unit	Unit Thickness	Depth to Top
Subs. SWL	Date	Analysis	Aquifer Test

Driller's Remarks

SCREEN DATA

Diameter - Inches	Length - Feet	Slot Size - Inches
16"	40'	.050

Screen Type	Depth to Bottom - Feet
PVC	118'

Top of Lap Pipe or Reduction in Casing

IF TELESCOPED OR MORE THAN ONE SCREEN, USE BACK PAGE

DESCRIPTION OF FORMATIONS ENCOUNTERED	FROM	TO
Clay	0	13
Clay, Fine Sand	13	23
Fine Sand	23	33
Borderline Sand	33	43
Borderline Sand	43	53
Coarse Sand	53	63
Coarse Sand, Pea Gravel	63	118

FORMATIONS (Continued)	FROM	TO
IF MORE SPACE IS NEEDED, USE BACK		

RECEIVED
SEP 18 2000
Dept. of Environmental Quality
Office of Land & Water Resources

8348

If well telescopes please sketch and show depths.

GROUND LEVEL

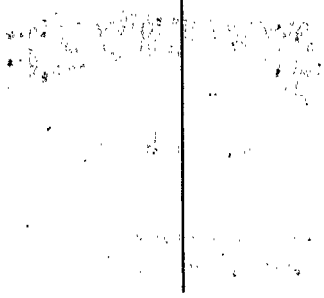

If more than one screen, show location of each on sketch.

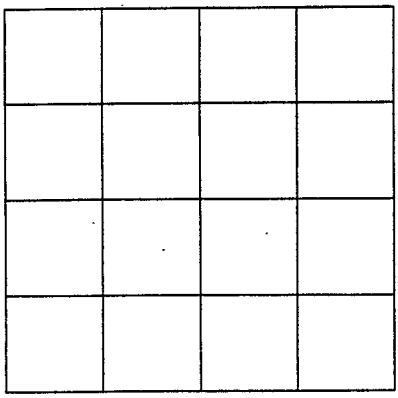

SECTION _____

Please indicate well location X.

ADDITIONAL INFORMATION