WASH
CL-1017 P 82
8-12-78

MISSISSIPPI BOARD OF WATER COMMISSIONERS
416 North State Street
Jackson, Mississippi 39201

WATER WELL DRILLERS LOG

8-12 (date well completed) 1978 — LAYNE CENTRAL CO. (firm name) — WASHINGTON (county well located)

LANDOWNER: D & W JONES, INC.
HOLLANDALE, MS
(mailing address)

WELL LOCATION:
sec. 22 T 15 N R 6 W
4 (distance) miles SE (direction) of Holland. (nearest town)

WELL PURPOSE: Irrigation
(home, irrigation, municipal, industrial)

WELL COMPLETION DATA:

(1) diameter (inches) 16"
(2) total depth (feet) 121'
(3) static water level (feet) 19 below ~~above~~ top of ground.
(4) casing Steel (material), 59' (depth),
16" (size) if telescope see back.
(5) screen 40' (length), 59' (depth to top)
16" (size), St. Steel (material)
(6) pump 50 (HP) 2400 (yield gpm)
Diesel (type power)
(7) electric log No (yes or no)
(organization running log)
(8) how well bottom plugged St.Plate

DRILLERS REMARKS:

description of formations encountered	from	to
Clay	0	22
fine sand	22	42
coarse sand & pea gravel	42	52
fine sand	102	109
coarse sand	109	120

RECEIVED
NOV 10 1978
MISS. BD. OF WATER COMM

If well telescopes please sketch and show depths.

GROUND LEVEL

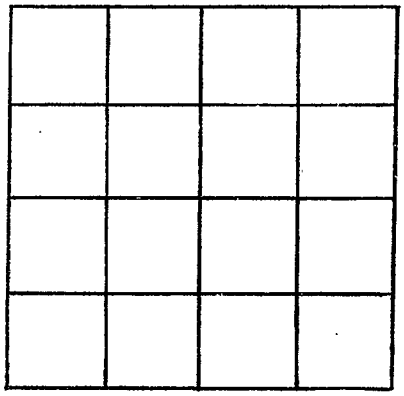

SECTION _____

Please indicate well location X.

ADDITIONAL INFORMATION

If more than one screen, show locations of each on sketch.