MISSISSIPPI DEPARTMENT OF NATURAL RESOURCES

Bureau of Land and Water Resources

P.O. Box 10631
Jackson, Mississippi 39209

WATER WELL DRILLERS LOG

COUNTY WELL LOCATED	Washington
WELL NUMBER	Q 110
CODED	✓
PERMIT NUMBER	7191
NAME OF DRILLING FIRM	Larrys Well & Pump
DATE WELL COMPLETED	6-30-87

NAME & MAILING ADDRESS OF LANDOWNER

Garrel Potter

Tam-an

Belzoni Ms.

WELL LOCATION: SEC 3 TOWNSHIP 15 (N) S RANGE 5 (E) W

NW¼ of NE¼

DISTANCE 12 Miles DIRECTION West of NEAREST TOWN Belzoni

OTHER LANDMARK

WELL PURPOSE: Home, Irrigation, Municipal, Industrial, Fish Pond, etc.

PUMP DATA

PUMP TYPE (Circle One): Submersible, Turbine, Jet Flowing Well, Other (Describe)

POWER TYPE (Circle One): Electric, Tractor, Diesel, Gasoline, Butane, Other (Describe)

Pump Capacity (GPM)	No. of Stages	Setting Depth
3000	1	60' FT.

PUMP TEST none

Well yielded _____ GPM with

a drawdown of _____ ft.

after _____ hours of pumping

WELL DATA

Well Depth	Casing Diameter (In.)	Casing Length (Ft.)
120'	16"	80'

Type of Casing	Hole Depth	Depth to Static Water Level
Steel	12'	30'

TYPE OF COMPLETION: (Circle One or More): Gravel Packed, Underreamed, Telescoped, Natural Development, Open Hole, Other (Describe)

Top of Lap Pipe or Reduction in Casing FEET

IF TELESCOPED OR MORE THAN ONE SCREEN: USE BACK PAGE

LOG DATA

TYPE OF LOG RUN (Circle One): No Log Run, Electric, Gamma Ray, Density, Sonic, ~~Neutron~~, Other (Describe)

Name of Organization Running Log

GEOLOGIC DATA (Office Use Only)

Surface Elev.	Geologic Unit	Unit Thickness	Depth to Top
Subs. SWL	Date	Analysis	Aquifer Test

Driller's Remarks

SCREEN DATA

Diameter - Inches	Length - Feet	Slot Size - Inches
16"	40'	60,000

Screen Type	Depth to Bottom - Feet
Steel	120'

DESCRIPTION OF FORMATIONS ENCOUNTERED	FROM	TO
Clay	0	30
Fine sand	30	70
Coarse sand & gravel	70	120

FORMATIONS CONTINUED

FROM	TO

RECEIVED

DEC 11 1987

Department of Natural Resources
Bureau of Land & Water Resources

IF MORE SPACE IS NEEDED, USE BACK

If well telescopes please
sketch and show depths.

GROUND LEVEL

If more than one screen,
show location of each on sketch.

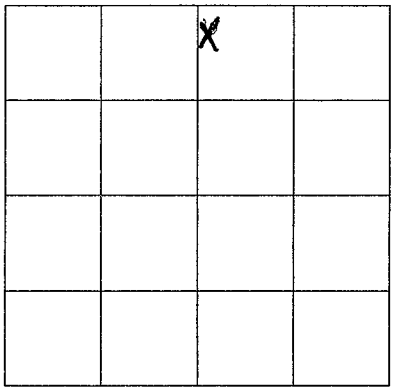

SECTION 4

Please indicate well location X.

ADDITIONAL INFORMATION