MISSISSIPPI DEPARTMENT OF ENVIRONMENTAL QUALITY
Office of Land and Water Resources
P. O. Box 10631
Jackson, MS 39289-0631
WATER WELL DRILLERS LOG

COUNTY WELL LOCATED	WASHINGTON
WELL NUMBER	Q 2010
CODED	
PERMIT NUMBER	
NAME OF DRILLING FIRM	LAYNE-CENTRAL, a division of Layne Christensen Company
DATE WELL COMPLETED	5/3/98

NAME & MAILING ADDRESS OF LANDOWNER
TORREY WOOD & SON
P.O. BOX 427
HOLLANDALE, MS 38748

WELL LOCATION: SEC 21 TOWNSHIP 15 N RANGE 5 W

DISTANCE 12 Miles DIRECTION SE of NEAREST TOWN HOLLANDALE

OTHER LANDMARK

WELL PURPOSE: Home, (Irrigation), Municipal, Industrial, Fish Pond, etc.
IRRIGATION

PUMP DATA

PUMP TYPE (Circle One): Submersible, (Turbine), Jet, Flowing Well, Other (Describe)

POWER TYPE (Circle One): Electric, Tractor, (Diesel), Gasoline, Butane, Other (Describe) H/P

Pump Capacity (GPM)	No. of Stages	Setting Depth
2500	1	60 FT.

PUMP TEST

Well yielded NOT TESTED GPM with a drawdown of ft. after hours of pumping

WELL DATA

Well Depth	Casing Diameter (In.)	Casing Length (Ft.)
124'	16"	74'

Type of Casing	Hole Depth	Depth to Static Water Level
PVC	124'	24'6"

TYPE OF COMPLETION: (Circle One or More): (Gravel Packed), Underreamed, Telescoped, Natural Development, Open Hole, Other (Describe)

WELL GROUTED TO A DEPTH OF 10 FEET
Type Grout (circle one): (Cement), Bentonite, or Mix

LOG DATA

TYPE OF LOG RUN (Circle One): (No Log Run), Electric, Gamma Ray, Density, Sonic, Neutron, Other (Describe)

Name of Organization Running Log

GEOLOGIC DATA (Office Use Only)

Surface Elev.	Geologic Unit	Unit Thickness	Depth to Top
Subs. SWL	Date	Analysis	Aquifer Test

Driller's Remarks

08-24-98A9:42 RCVD

Top of Lap Pipe or Reduction in Casing FEET

IF TELESCOPED OR MORE THAN ONE SCREEN: USE BACK PAGE

SCREEN DATA

Diameter - Inches	Length - Feet	Slot Size - Inches
16"	50'	.050

Screen Type	Depth to Bottom - Feet
PVC	124'

DESCRIPTION OF FORMATIONS ENCOUNTERED	FROM	TO	FORMATIONS (Continued)	FROM	TO
CLAY	0	22			
SAND	22	50			
COARSE SAND	50	79			
GRAVEL SAND	79	124			
			IF MORE SPACE IS NEEDED, USE BACK		

If well telescopes please
sketch and show depths.

GROUND LEVEL

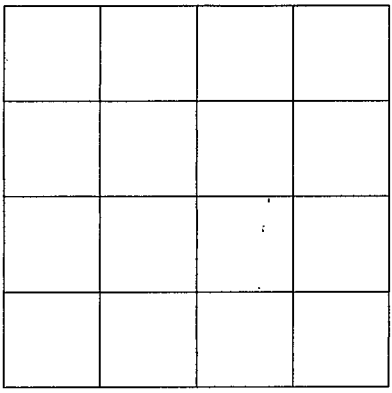

SECTION _____

Please indicate well location X.

ADDITIONAL INFORMATION

If more than one screen,
show location of each on sketch.