Wayne
B 28
7-3-75

MISSISSIPPI
BOARD OF WATER COMMISSIONERS
416 North State Street
Jackson, Mississippi 39201

CODED

WATER WELL DRILLERS LOG

July 3, 1975 19 — McILWAIN WATER WELL SERVICE — Wayne
date well completed — firm name — county well located

RT. 2, BOX 37
WAYNESBORO, MISS. 39367

LANDOWNER:
Mr. Albert Fleming
Rt 1 Shubuta, Miss
(mailing address)

WELL LOCATION:
sec. 31 T 10 N R 8 E W 13P
3 miles SE of Eucutta
(distance) (direction) (nearest town)

WELL PURPOSE: HOME
(home, irrigation, municipal, industrial)

WELL COMPLETION DATA:

(1) diameter (inches) 2"
(2) total depth (feet) 150
(3) static water level (feet) 79' below ~~above~~ top of ground.
(4) casing PVC (material), 130' (depth), 2" (size) if telescope see back.
(5) screen NONE (length), _____ (depth to top), _____ (size), _____ (material)
(6) pump 1 (HP) 4 (yield gpm) 220 AC (type power)
(7) electric log no (yes or no)
_____ (organization running log)
(8) how well bottom plugged _____

DRILLERS REMARKS: _____

description of formations encountered	from	to
Sandy Clay	0	10
Red Sand	10	20
Coarse Red sand	20	31
Clay	31	33
Sand + Clay	33	50
Blue Clay	50	69
Rock + Limy Clay	69	85
Blue Clay	85	119
Honeycomb Rock	119	150

RECEIVED
JUL 24 1975
MISS. BD. OF WATER COMM.

If well telescopes please sketch and show depths.

GROUND LEVEL

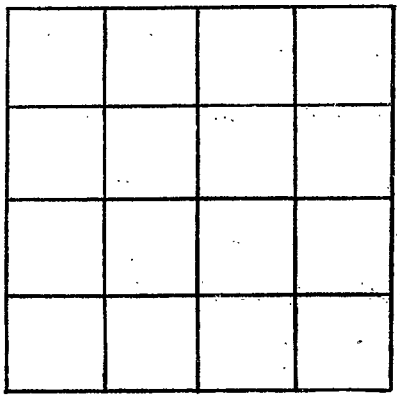

SECTION _____

Please indicate well location X.

ADDITIONAL INFORMATION

If more than one screen, show locations of each on sketch.