C. P. CLARK
WATER WELL DRILLING
ROUTE 2
LAUREL, MISS. 39440

Wayne Co.
F 30
2-69

MISSISSIPPI
BOARD OF WATER COMMISSIONERS
416 North State Street
Jackson, Mississippi 39201

WATER WELL DRILLERS LOG

2/12 1969 — date well completed
C. P. Clark — firm name
Wayne — county well located

LANDOWNER: Tom Bryan
Rt #1 Laurel Miss
(mailing address)

WELL LOCATION:
sec. 32 T. 9 (N) S R. 9 (W) E
14 (distance) miles East (direction) of Laurel (nearest town)

WELL PURPOSE: Home
(home, irrigation, municipal, industrial)

WELL COMPLETION DATA:
(1) diameter (inches) 2
(2) total depth (feet) 72
(3) static water level (feet) 52 below above top of ground.
(4) casing Galv. Steel (material), 67 (depth),
2 (size) if telescope see back.
(5) screen 5 (length), 67 (depth to top)
1 1/4 (size), S.S. (material)
(6) pump 3/4 (HP) 10 (yield gpm)
220 S.P. (type power)
(7) electric log no (yes or no)
(organization running log)
(8) how well bottom plugged B.W.V.

DRILLERS REMARKS:

description of formations encountered	from	to
Clay	0	30
Sand (Mud)	30	72

MAR 10 1969
MISS. BD. OF WATER COMM.

If well telescopes please sketch and show depths.

GROUND LEVEL

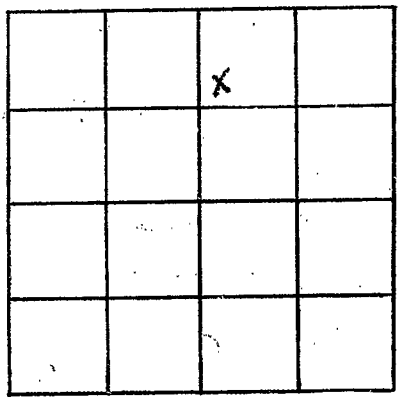

SECTION 32

Please indicate well location X.

ADDITIONAL INFORMATION

If more than one screen, show locations of each on sketch.