MISSISSIPPI DEPARTMENT OF NATURAL RESOURCES

Bureau of Land and Water Resources

P.O. Box 10631
Jackson, Mississippi 39209
WATER WELL DRILLERS LOG

COUNTY WELL LOCATED	Wayne
WELL NUMBER	F
CODED	
PERMIT NUMBER	
NAME OF DRILLING FIRM	Arthur Daly Drlg. Inc. Laurel, Ms
DATE WELL COMPLETED	10/12/89

NAME & MAILING ADDRESS OF LANDOWNER
Mrs. Sybil Chancellor
12 Oakcrest Dr.
Laurel, Ms.

WELL LOCATION:	SEC	TOWNSHIP	RANGE
SW SW	34	9 N	9 W

DISTANCE	DIRECTION	NEAREST TOWN
3 Miles	W	Whistler

OTHER LANDMARK

WELL PURPOSE: Home, Irrigation, Municipal, Industrial, Fish Pond, etc.

PUMP DATA

PUMP TYPE (Circle One): Submersible, Turbine, Jet, Flowing Well, Other (Describe)

POWER TYPE (Circle One): Electric, Tractor, Diesel, Gasoline, Butane, Other (Describe)

Pump Capacity (GPM)	No. of Stages	Setting Depth
5	2	42 FT.

PUMP TEST

Well yielded 5 GPM with a drawdown of — ft. after — hours of pumping

WELL DATA

Well Depth	Casing Diameter (In.)	Casing Length (Ft.)
53	2	42

Type of Casing	Hole Depth	Depth to Static Water Level
Sch40PVC	53	30' (G.L.)

TYPE OF COMPLETION: (Circle One or More): Gravel Packed, Underreamed, Telescoped, Natural Development, Open Hole, Other (Describe)

Top of Lap Pipe or Reduction in Casing FEET

IF TELESCOPED OR MORE THAN ONE SCREEN: USE BACK PAGE

LOG DATA

TYPE OF LOG RUN (Circle One): No Log Run, Electric, Gamma Ray, Density, Sonic, Neutron, Other (Describe)

Name of Organization Running Log

GEOLOGIC DATA (Office Use Only)

Surface Elev.	Geologic Unit	Unit Thickness	Depth to Top
Subs. SWL	Date	Analysis	Aquifer Test

Driller's Remarks

SCREEN DATA

Diameter - Inches	Length - Feet	Slot Size - Inches
2	5	.008

Screen Type	Depth to Bottom - Feet
Slotted sch80PVC	47

RECEIVED
OCT 16 1989
Department of Natural Resources
Bureau of Land & Water Resources

DESCRIPTION OF FORMATIONS ENCOUNTERED	FROM	TO
Top soil	0	1
Red sandy clay	1	9
Sand	9	47
Tan clay	47	53

FORMATIONS (Continued)	FROM	TO

IF MORE SPACE IS NEEDED, USE BACK

If well telescopes please
sketch and show depths.

GROUND LEVEL

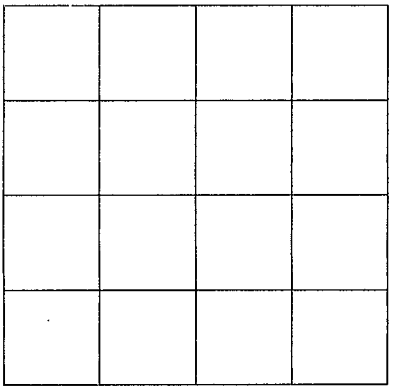

SECTION _____

Please indicate well location X.

ADDITIONAL INFORMATION

If more than one screen,
show location of each on sketch.