

G29

1-5-63

WATER WELL DRILLERS LOG

Date: Jan 5, 1963, Driller: Porter Drilling & Sps County: Wayne
(Name)

(1) Owner of Land: <u>Woodrow Reynolds</u> <small>(Name)</small>	Description & Color of Materials Sand, Clay, Red Clay, Shell, etc.	Thick- ness Feet	Depth Feet
<u>Rt 1 Shubuta, Miss.</u> <small>(Address)</small>	<u>red sand</u>	<u>8</u>	<u>8</u>
(2) Location: <u>SE 1/4, NW 1/4, Sec. 6 T9R8</u> , <u>15</u> miles <u>NW</u> of <u>Waynesboro</u> <small>(direction) (distance) (Nearest Town)</small>	<u>white chalk</u>	<u>12</u>	<u>20</u>
(3) Topography: <u>hilly</u> <small>(Hilly) (Flat) (Level)</small>	<u>red chalk</u>	<u>8</u>	<u>28</u>
(4) Purpose of Well: <u>domestic</u> <small>(Domestic Irrigation Municipal, Industrial, Other)</small>	<u>blue chalk</u>	<u>28</u>	<u>56</u>
	<u>sand & chalk</u>		
	<u>reject</u>		
	<u>very poor sand</u>	<u>14</u>	<u>70</u>
	<u>stopped on chalk</u>		


Information upon completion of well:

- (1) Diameter 2" inches.
- (2) Total Depth 70' feet.
- (3) Water Level 45' feet below top of ground.
- (4) Cased to 58, Size 2"
- (5) Screen: Size 1/4, Length 12'
- (6) Were any formations sealed against pollution?
 yes, no.

If YES depth of formation _____

Why _____

Drillers Remarks: _____

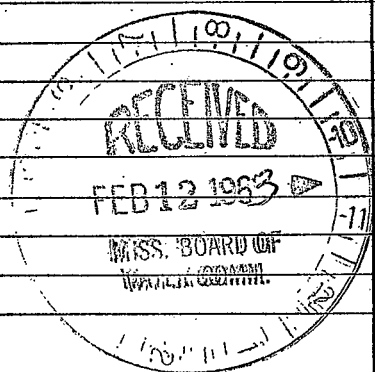

(Use Back Side)

Well No.




