WAYNE
G 2032
8-5-81

MISSISSIPPI DEPARTMENT OF NATURAL RESOURCES
Bureau of Land and Water Resources
Southport Mall
P.O. Box 10631
Jackson, Mississippi 39209

WATER WELL DRILLERS LOG

Aug 5 1981 Porter Drilling & Sup. Wayne
date well completed — firm name — county well located

LANDOWNER: Lee Roy Williams
Rt 1 Shubuta
(mailing address)

WELL LOCATION:
sec 2 T 9 (N/S) R 8 (E/W)
7 miles NW of Waynesboro
(distance) (direction) (nearest town)

WELL PURPOSE: home
(home, irrigation, municipal, industrial)

WELL COMPLETION DATA:
(1) diameter (inches) 2"
(2) total depth (feet) 118'
(3) static water level (feet) 23 (below) above top of ground.
(4) casing P.V.C. (material), 113' (depth)
2" (size) If telescope see back.
(5) screen 5' (length), 113' (depth to top)
2", Bell SS. (size), (material)
(6) pump 2 (HP) 10 (yield gpm)
elec (type power)
(7) electric log no (yes or no)
(organization running log)
(8) how well bottom plugged 2' sand shale

DRILLERS REMARKS:

description of formations encountered	from	to
Clay	0	15
Clay & sand	15	67
sand & pea gravel	67	90
sand	90	118
stopped on rock		
102' 1" PVC drop pipe		

DEPT. OF NATURAL RESOURCES
BUREAU OF LAND & WATER RESOURCES
SEP -9 1981
RECEIVED

If well telescopes, please sketch and show depths.

RECEIVED SEP 1981

GROUND LEVEL

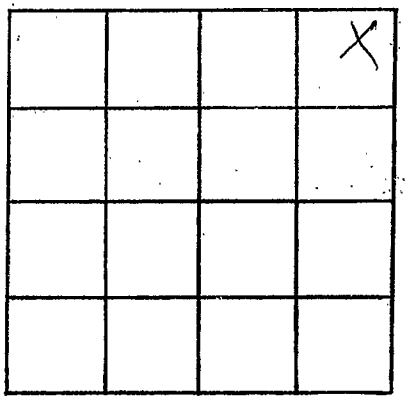

SECTION 2

Please indicate well location X.

ADDITIONAL INFORMATION

If more than one screen, show locations of each on sketch.